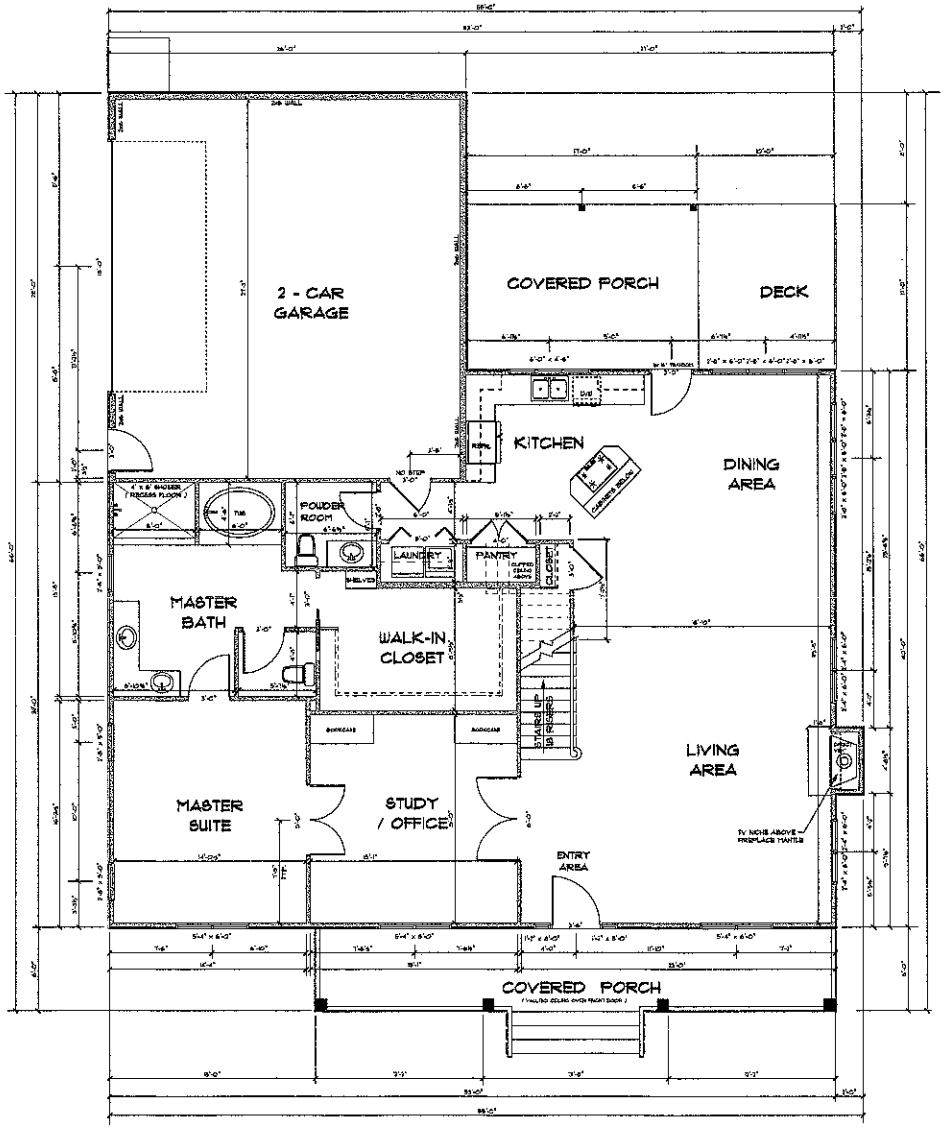


AREA CALCULATIONS

HEATED:

FIRST FLOOR	1,851 S.F.
SECOND FLOOR	1,185 S.F.
TOTAL HEATED	3,036 S.F.

UNHEATED:

BONUS ROOM	538 S.F.
GARAGE	718 S.F.

Approved As Noted
Please submit revised plans
Judy Melville Date 1-19-11
Ty Kelly Date 1-19-11

1 / A-1 MAIN FLOOR PLAN

SCALE: 1/4" = 1'-0" 10'-1 1/2" CEILING HEIGHT

12-20-10

©COPYRIGHT 2010, U.S. Home Designs, Inc. ALL RIGHTS RESERVED


Plans by: U.S. HOME DESIGNS, INC.
1810 Peach Blossom Cir., Harrisburg, NC 28075 704-644-4400
Designer: Stephen W. Tarwig cell# 704-809-0762 swtarwig@msn.com

Kelly Custom Builders, Inc.
P.O. Box 3276, Mooresville, NC 28117
704-987-7755
www.kellycustombuildersinc.com

WILSON RESIDENCE
MAIN FLOOR PLAN
SCALE: 1/4" = 1'-0"

SHEET No. A-1 OF 8

KNEEWALL HEIGHTS AND CLIPPED CEILING
LOCATIONS ARE BASED ON A 8 / 12 PITCH ROOF
AFTER 12" FURR-DOWN FOR INSULATION
(GARAGE / BONUS ROOF IS 10 / 12)

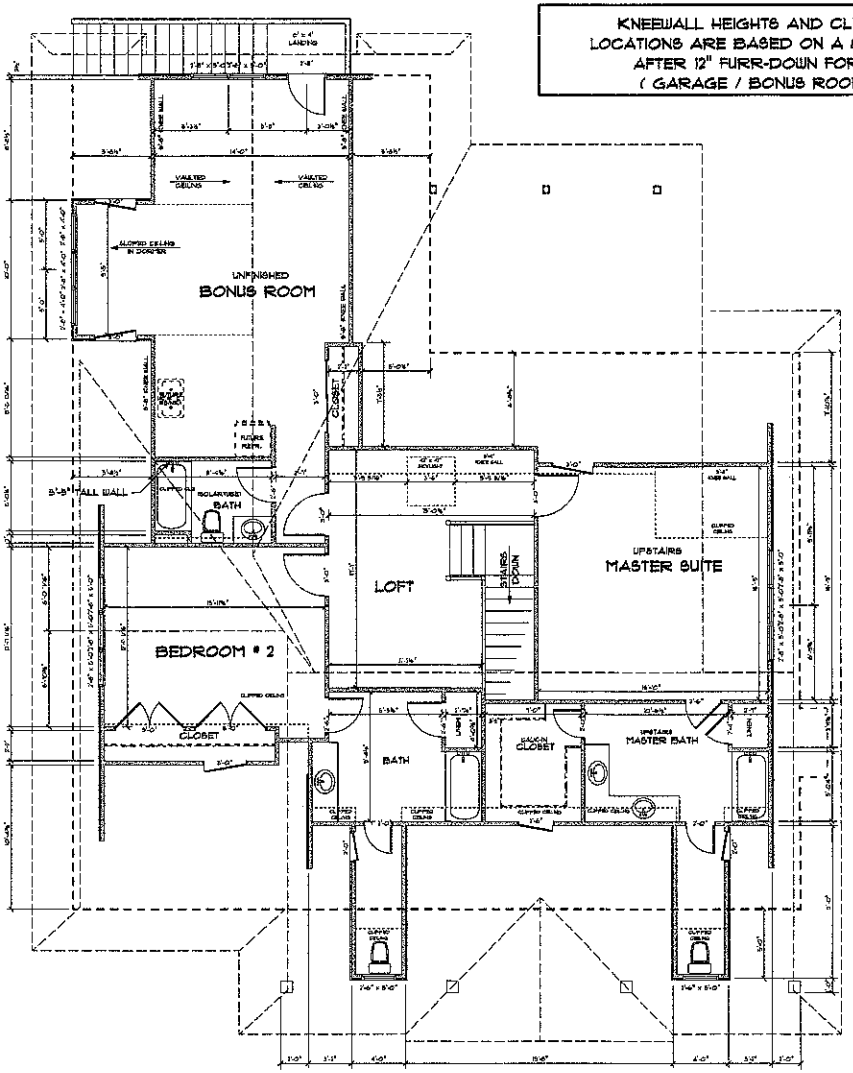

1 / A-2 UPPER FLOOR PLAN
SCALE: 1/4" = 1'-0" 9'-1 1/2" CEILING HEIGHT

12-20-10

©COPYRIGHT 2010, U.S. Home Designs, Inc. ALL RIGHTS RESERVED

Approved as noted
Kelly Custom Builders, Inc.
Andy Medgille 1-19-11
Ty Kelly 1-19-11

Plans by: U.S. HOME DESIGNS, INC.
1810 Fleish Blossom Ct., Harrisburg, NC 28075 704-644-4400
Designer: Stephen W. Turley cell: 704-309-0762 sturley@mac.com

Commercial/Residential KELLY CUSTOM BUILDERS, INC.
Kelly Custom Builders, Inc.
P.O. Box 3276 Mooresville, NC 28117
704-987-7755
www.kellycustombuildersinc.com

WILSON RESIDENCE
UPPER FLOOR PLAN
SCALE: 1/4" = 1'-0"

SHEET No. A-2 OF 8