4646420312

IREDELL COUNTY HEALTH DEPARTMENT

STATESVILLE 704-878-5305 MOORESVILLE 704-664-5281

IMPROVEMENT PERMIT / CERTIFICATE OF COMPLETION / OPERATION PERMIT / EXISTING SYSTEM INSPECTION

PROPERTY DESCRIPTION NO. 19309 DATE Dec 13, 194 TAX MAP NO. ? NOT ON P.D. Watershed: ☑ Yes ☐ No

OWNER OR CONTRACTOR Faith Baptist Church PHONE: Business _____ Home _____

ADDRESS 254 Catalina Ln. Mooresville

LOCATION 215 x I77 Tr 1206 (Alcove) TR Catalina ½ mile on Rt.

SUBDIVISION _____ BLOCK / SECTION _____ LOT _____ LOT AREA Existing 3AC SITE CLASS. PS DESIGN FLOW 150 gpd L.T.A.R. .25-.3

Septic Tank: 1000 Gallons; STB 794 Date 5-15-95

Pump Tank: _____ Gallons; PT _____ Date _____

Pump Make: _____ Model _____ Serial No. _____

Nitrification Field: No Fields 1 Square Feet 600 Linear Feet 200

No Lines 3 Trench Width 36" Max Trench Bottom Depth 24" Gravel Depth 12"

☑ New System ☐ Repair System Type: I, ☑ II, III, IV, V, VI

System Description: gravity conventional

Repair System Description: SAME

Maintenance Agreement Required: ☐ Yes ☑ No

☐ House/Mod. Home No. Bedrooms —

☐ Mobile Home No. Bathrooms 2

☐ Business No. Employees _____

☑ Other Church Fellowship Hall


☑ Slab ☐ Crawl Space ☐ Basement w/plumbing ☐ Basement wo/plumbing

Water Supply:
☑ Individual
☐ Community
☐ Public


Comments:

Comments:

INITIAL SITE SKETCH

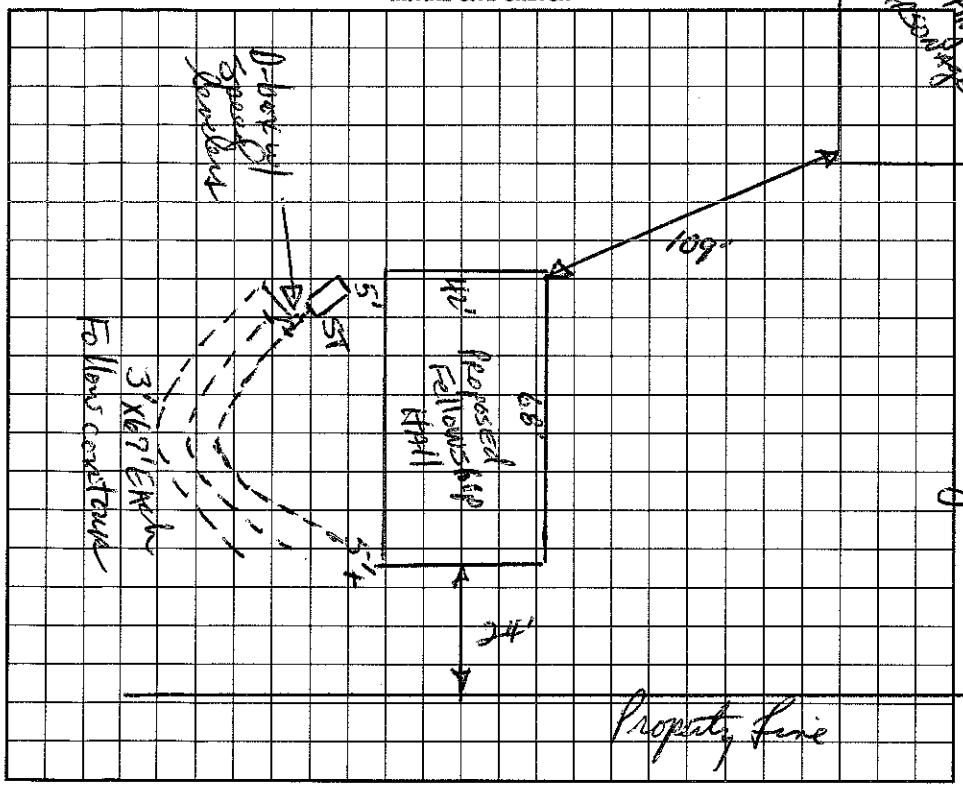

AS BUILT SKETCH

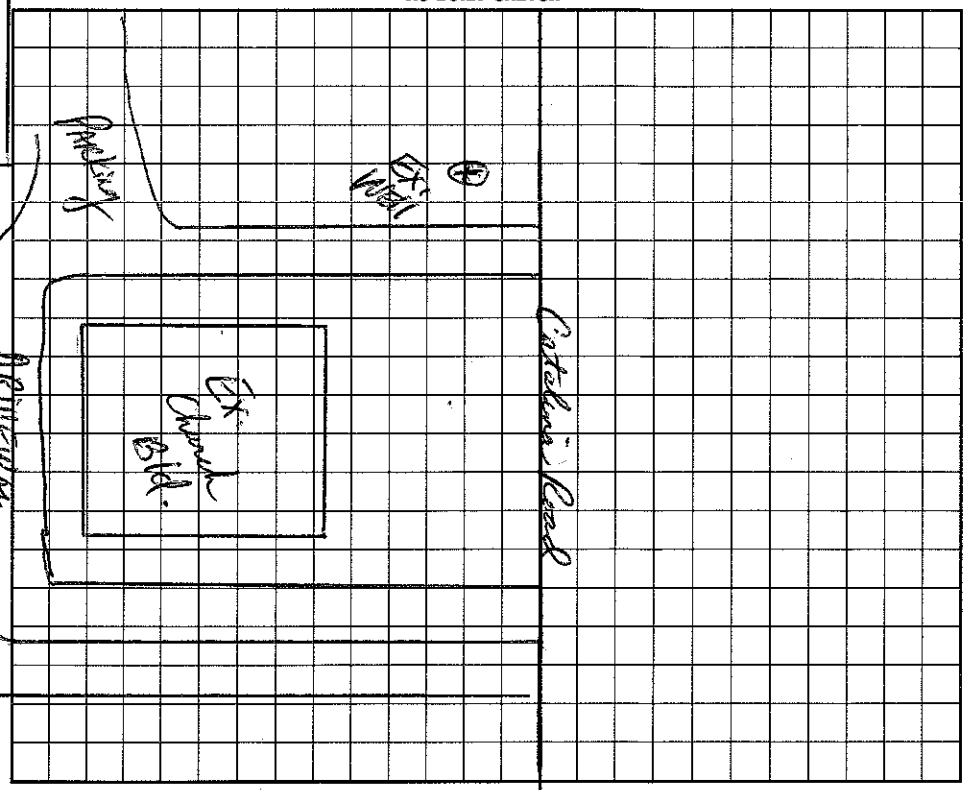

I understand that this permit can be suspended or revoked if any false information is supplied toward securing the permit/any unauthorized changes are made to the site/any unauthorized changes are made in the installation of the system. Improvement Permit is valid for 60 months from date of issuance.

Signed: X Craig Stephens

Improvement Permit by: Jack R. Hinson, RS date 12/13/94

Existing System Inspection by: _____ date _____

Installed by: Church Members

Certificate of Completion by: Jack R. Hinson RS date 7-17-95

Operation Permit by: _____ date _____

HEALTH DEPT. COPY: WHITE INSPECTION COPY (FINAL): GREEN OWNER COPY (FINAL): YELLOW INSPECTION COPY (INITIAL): PINK OWNER COPY (INITIAL): GOLD