IREDELL COUNTY HEALTH DEPARTMENT

STATESVILLE 704-878-5305 MOORESVILLE 704-664-5281

IMPROVEMENT PERMIT / AUTHORIZATION TO CONSTRUCT / OPERATION PERMIT / EXISTING SYSTEM INSPECTION

PERMIT# 074514 PIN# 4646 42 ~~58~~ 54 4145 DATE 8/~~22~~/98

OWNER OR CONTRACTOR RANDY WELBORN PHONE: Business 896-9886 Home

ADDRESS 8716 HWY 73 SUITE 100 CORNELIUS NC 28031

LOCATION ALCOVE-TR CATALINA - ON RT JUST PAST CATALINA PLACE DRIVE

SUBDIVISION CATALINA PLACE BLOCK / SECTION LOT 2 LOT AREA .48AC SITE CLASS. PS DESIGN FLOW 360GPD L.T.A.R. .30 GPD/FT

Septic Tank: 1000 Gallons; STB 525 Date 5-4-99
Pump Tank: Gallons; PT Date
Pump Make: Model Serial No.
Nitrification Field: No Fields 1 Square Feet 900 Linear Feet 300
No Lines 4@75' Trench Width 36" Max Trench Bottom Depth 36" Gravel Depth N/A

☑ New System ☐ Repair System Type: I, II, (III), IV, V, VI
System Description: GRAVITY CHAMBERS OR EQ
Repair System Description: GRAVITY/PUMP PANEL
Maintenance Agreement Required: ☐ Yes ☑ No

☑ House/Mod. Home No. Bedrooms 3
☐ Mobile Home No. Bathrooms 2
☐ Business No. Employees
☐ Other


☐ Slab ☐ Crawl Space ☐ Basement w/plumbing ☐ Basement wo/plumbing

Water Supply: ☑ Individual ☐ Public ☐ Community

Comments:/Conditions:

Comments:/Conditions:

INITIAL SITE SKETCH 1"=50'

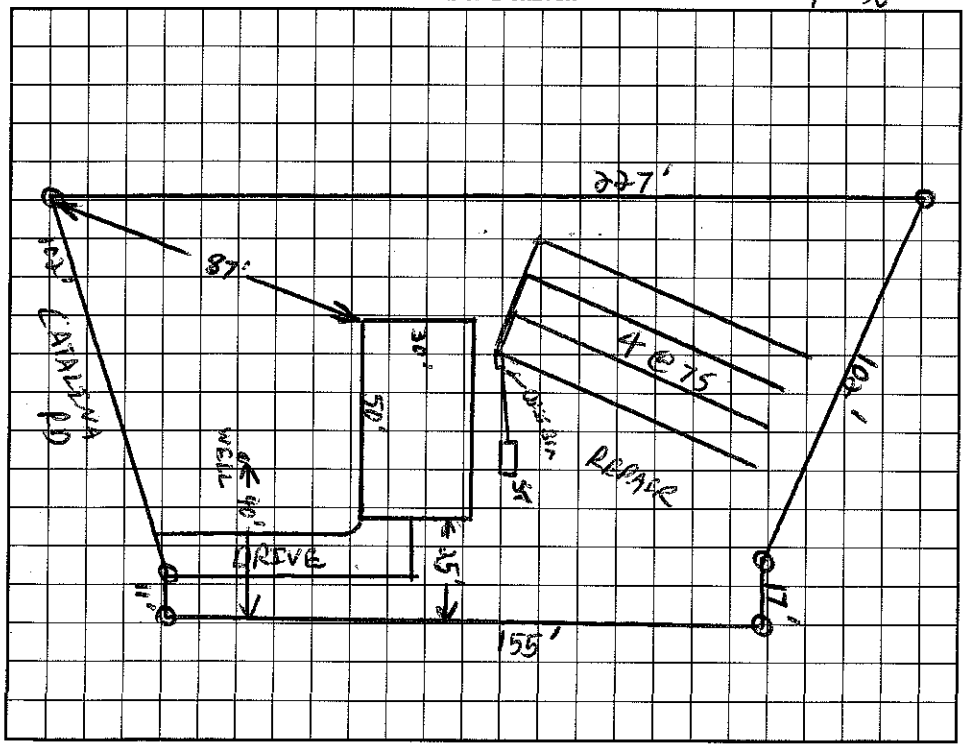

AS BUILT SKETCH

I understand that this permit can be suspended or revoked if any false information is supplied toward securing the permit/any unauthorized changes are made to the site/any unauthorized changes are made in the installation of the system. Improvement Permit with plat valid without expiration. Improvement Permit with site plan valid for sixty months. Authorization to Construct is valid for a period equal to that of Improvement Permit – not to exceed sixty months.

Signed: [signature] date 8/27/98 Installed by: Andy Daniels

Improvement Permit by: C. Nathan RS date 8/22/98 Operation Permit by: Jeff Morgan date 7-1-99

Authorization to Construct by: C. Nathan RS date 8/22/98 Existing System Inspection by: date

HEALTH DEPT. COPY: WHITE INSPECTION COPY (FINAL): GREEN OWNER COPY (FINAL): YELLOW INSPECTION COPY (INITIAL): PINK OWNER COPY (INITIAL): GOLD