IREDELL COUNTY HEALTH DEPARTMENT

STATESVILLE 704-878-5305 MOORESVILLE 704-664-5281

IMPROVEMENT PERMIT / AUTHORIZATION TO CONSTRUCT / OPERATION PERMIT / EXISTING SYSTEM INSPECTION

PERMIT# 074513 PIN# 4646 42 5354 4646 42 5156 DATE 8/22/98

OWNER OR CONTRACTOR RANDY WELBORN PHONE: Business 596-9886 Home

ADDRESS 18 7/6 HWY 73 SUITE 100 CORNELIUS NC 28031

LOCATION ALCOVE - JR CATALINA - CORNER OF CATALINA PLACE DRIVE OF RT

SUBDIVISION CATALINA PLACE BLOCK / SECTION LOT 1 LOT AREA 1.46 AC SITE CLASS. PS DESIGN FLOW 360 GPD L.T.A.R. .30 GPD/FT

Septic Tank: 1000 Gallons; STB 794 Date 8/14/98

Pump Tank: 1000 Gallons; PT 27 Date 10/17/98

Pump Make: HYDROMATIC Model SK50M1 Serial No. 9/98

Nitrification Field: No Fields 1 Square Feet 900 Linear Feet 300

No Lines 5 Trench Width 36" Max Trench Bottom Depth 36" Gravel Depth N/A

☑ New System ☐ Repair System Type: I, II, III, IV, V, VI

System Description: PUMP CHAMBERS OR HDS

Repair System Description: PUMP PANEL

Maintenance Agreement Required: ☐ Yes ☑ No

☑ House/Mod. Home No. Bedrooms 3

☐ Mobile Home No. Bathrooms 2

☐ Business No. Employees

☐ Other


☐ Slab ☑ Crawl Space ☐ Basement w/plumbing ☐ Basement wo/plumbing

Water Supply: ☑ Individual ☐ Public ☐ Community

Comments:/Conditions:

Comments:/Conditions:

INITIAL SITE SKETCH 1"=50'

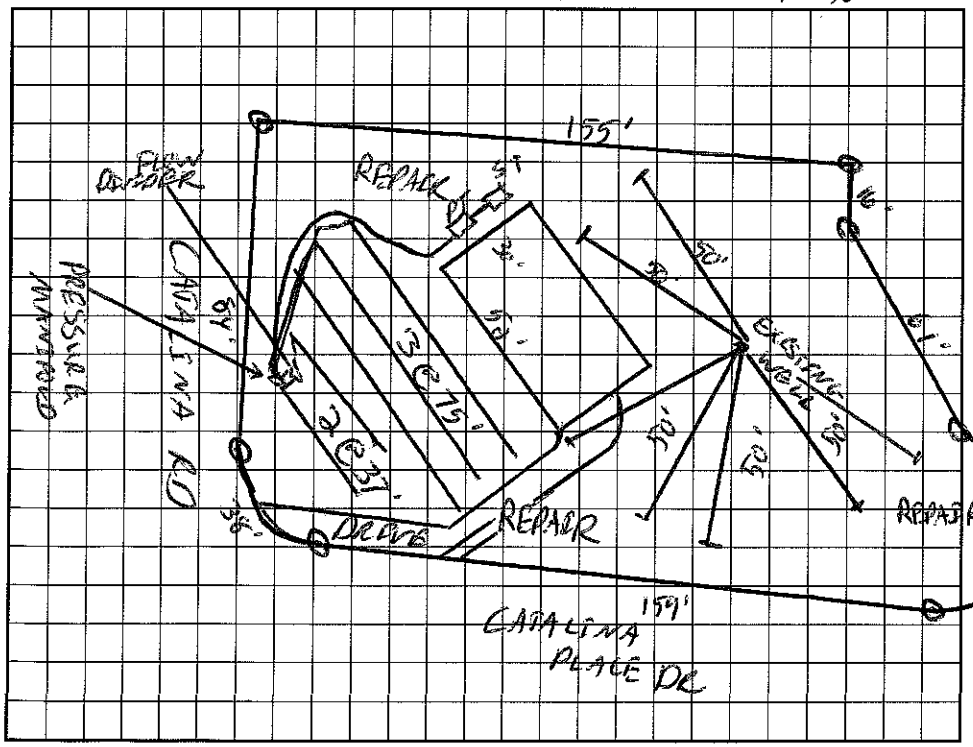

AS BUILT SKETCH

I understand that this permit can be suspended or revoked if any false information is supplied toward securing the permit/any unauthorized changes are made to the site/any unauthorized changes are made in the installation of the system. Improvement Permit with plat valid without expiration. Improvement Permit with site plan valid for sixty months. Authorization to Construct is valid for a period equal to that of Improvement Permit – not to exceed sixty months.

Signed: [signature] date 8/27/98 Installed by: Larry Beam

Improvement Permit by: [signature] RS date 8/22/98 Operation Permit by: [signature] R.S. date 12/7/98

Authorization to Construct by: [signature] RS date 8/25/98 Existing System Inspection by: date

HEALTH DEPT. COPY: WHITE INSPECTION COPY (FINAL): GREEN OWNER COPY (FINAL): YELLOW INSPECTION COPY (INITIAL): PINK OWNER COPY (INITIAL): GOLD