IREDELL COUNTY HEALTH DEPARTMENT

STATESVILLE 704-878-5305 MOORESVILLE 704-664-5281

IMPROVEMENT PERMIT / AUTHORIZATION TO CONSTRUCT / OPERATION PERMIT / EXISTING SYSTEM INSPECTION

PERMIT# 074515 PIN# 4646 42 5354 5409 DATE 5/22/98

OWNER OR CONTRACTOR RANDY WELBORN PHONE: Business 896-9886 Home

ADDRESS 18716 HWY 73 SUITE 100 CORNELIUS NC 28031

LOCATION ALCOVE - TR CATALINA - JR CATALINA PLACE - AT END OF CUL-DE-SAC

SUBDIVISION CATALINA PLACE BLOCK / SECTION LOT 4 LOT AREA .7 AC SITE CLASS. PS DESIGN FLOW 360GPD L.T.A.R. .3 GPD/FT2

Septic Tank: 1000 Gallons; STB 825 Date 5-4-79

Pump Tank: Gallons; PT Date

Pump Make: Model Serial No.

Nitrification Field: No Fields 1 Square Feet 900 Linear Feet 300

No Lines 4 @ 75' Trench Width 36" Max Trench Bottom Depth 36" Gravel Depth N/A

☑ New System ☐ Repair System Type: I, II, (III), IV, V, VI

System Description: GRAVITY CHAMBERS OR HS

Repair System Description: PUMP PANEL

Maintenance Agreement Required: ☐ Yes ☑ No

☑ House/Mod. Home No. Bedrooms 3

☐ Mobile Home No. Bathrooms 2

☐ Business No. Employees

☐ Other

☐ Slab ☐ Crawl Space ☐ Basement w/plumbing ☐ Basement wo/plumbing


Water Supply: ☑ Individual ☐ Public ☐ Community

Comments:/Conditions:

Comments:/Conditions:

1"=50'

INITIAL SITE SKETCH

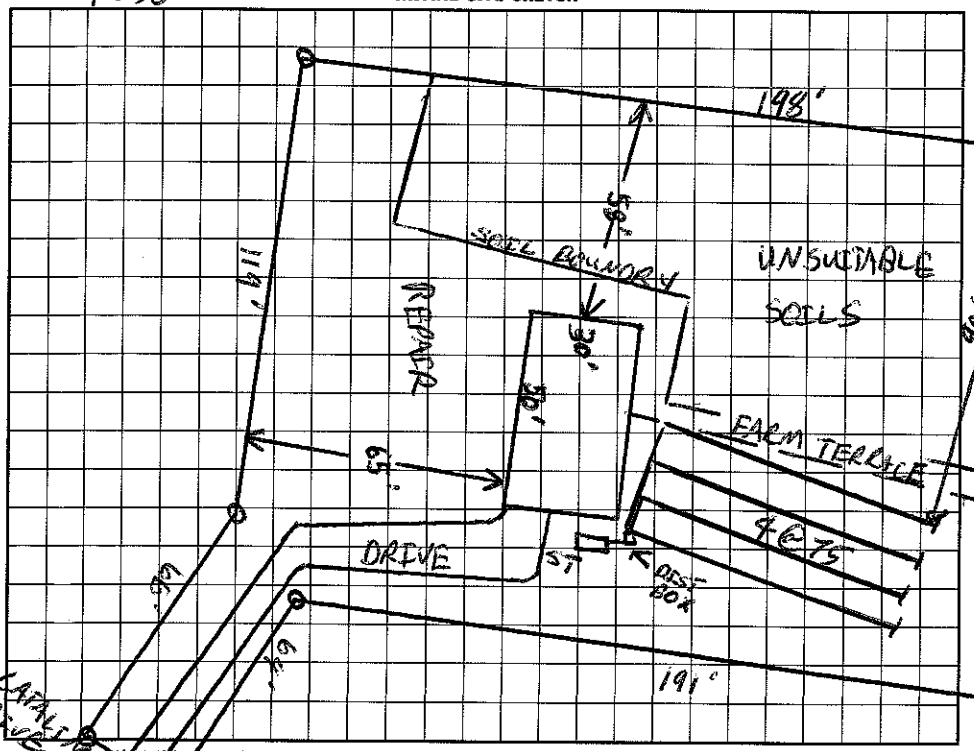

AS BUILT SKETCH

I understand that this permit can be suspended or revoked if any false information is supplied toward securing the permit/any unauthorized changes are made to the site/any unauthorized changes are made in the installation of the system. Improvement Permit with plat valid without expiration. Improvement Permit with site plan valid for sixty months. Authorization to Construct is valid for a period equal to that of Improvement Permit – not to exceed sixty months.

Signed: Janet M Lawrence date 8/27/98

Improvement Permit by: C. [illegible] Team RS date 5/22/98

Authorization to Construct by: C. [illegible] Team RS date 5/22/98

Installed by: Andy Daniels

Operation Permit by: Jeff Morgan date 7-1-99

Existing System Inspection by: date

HEALTH DEPT. COPY: WHITE INSPECTION COPY (FINAL): GREEN OWNER COPY (FINAL): YELLOW INSPECTION COPY (INITIAL): PINK OWNER COPY (INITIAL): GOLD