IREDELL COUNTY HEALTH DEPARTMENT Auth-Cust STATESVILLE 704-878-5305 MOORESVILLE 704-664-5[illegible]

IMPROVEMENT PERMIT / ~~CERTIFICATE OF COMPLETION~~ / OPERATION PERMIT / EXISTING SYSTEM INS[illegible]

PROPERTY DESCRIPTION NO. 23049 DATE Feb 16, '96 TAX MAP NO. 2H-2-A-2 4646 43 0933 Watershed: ☑ Yes ☐ No

OWNER OR CONTRACTOR Robert Stidel PHONE: Business 662-0822 Home

ADDRESS Hwy 136, Mocksville

LOCATION Williamson Rd. TR Pondcrosa ½ mile on Right

SUBDIVISION Bonanza BLOCK / SECTION 2 LOT 2 LOT AREA .652 Ac SITE CLASS PS pen. 1956 DESIGN FLOW 360 gpd L.T.A.R. ~.25

Septic Tank: 1000 Gallons; STB 825 Date 1/16/96

Pump Tank: 1000 Gallons; PT 47 Date 5/5/96

Pump Make: Model Serial No.

Nitrification Field: No Fields 1 Square Feet 480 Linear Feet 240

No Lines 4@60' Trench Width 24" Max Trench Bottom Depth ~ 28" Gravel Depth NA

☑ New System ☐ Repair System Type: I, II, (III), IV, V, VI

System Description: pumped-pan-panel block

Repair System Description: LP PPBPS

Maintenance Agreement Required: ☐ Yes ☑ No initially

☑ House/Mod. Home No. Bedrooms 3

☐ Mobile Home No. Bathrooms 2½

☐ Business No. Employees

☐ Other

☐ Slab ☑ Crawl Space ☐ Basement w/plumbing ☐ Basement wo/plumbing


Water Supply: ☑ Individual ☐ Community ☐ Public

Comments:


Comments: Lines, Tanks, Pressure checked 8/19/96

1" = 50'

INITIAL SITE SKETCH

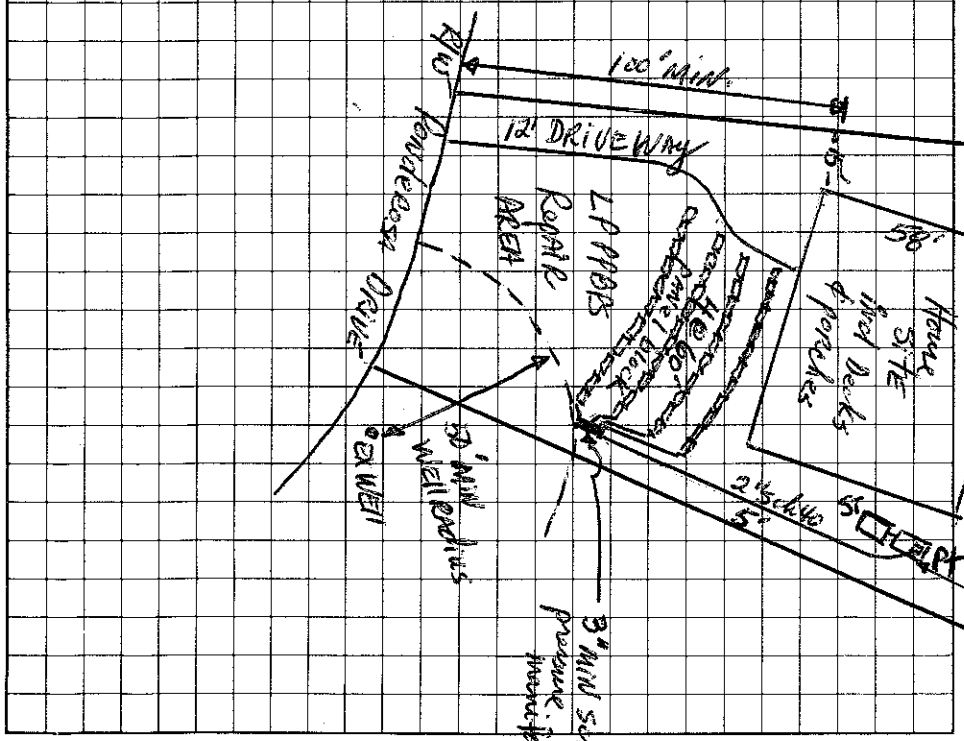

AS BUILT SKETCH

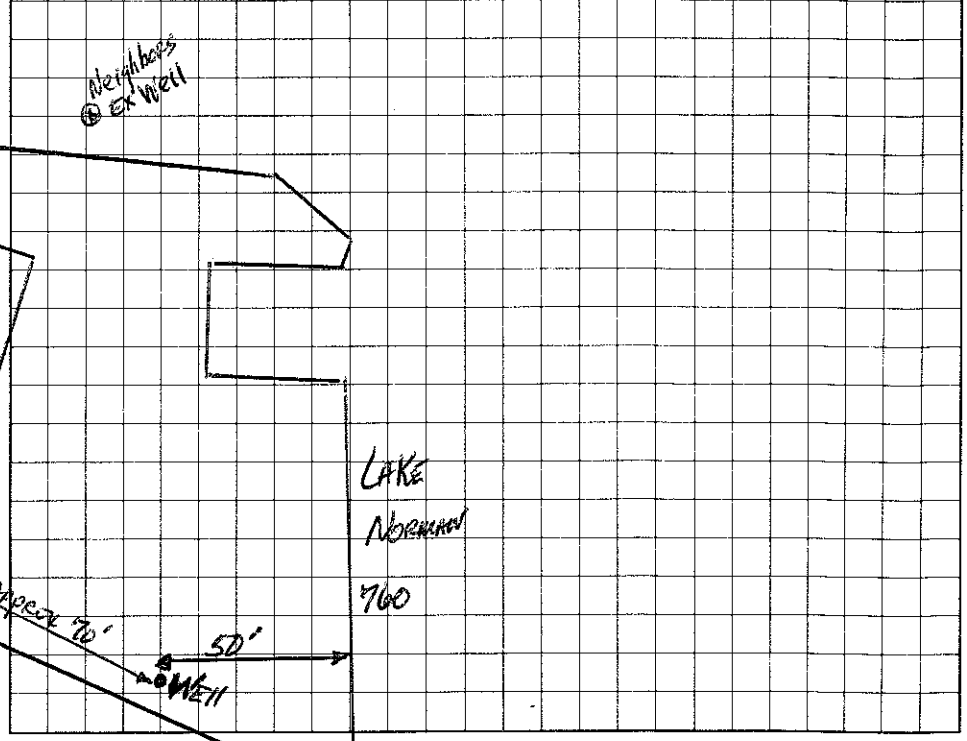

I understand that this permit can be suspended or revoked if any false information is supplied toward securing the permit/any unauthorized changes are made to the site/any unauthorized changes are made in the installation of the system.

Signed: [signature]

Improvement Permit by: [signature], RS date 2-16-96

~~Authorization to Construct~~ ~~Existing System Inspection by:~~ [signature], RS date 2-16-96

Installed by: Ronnie Dye Backhoe

Certificate of Completion by: date

Operation Permit by: [signature] date 8/20/96

HEALTH DEPT. COPY: WHITE INSPECTION COPY (FINAL): GREEN OWNER COPY (FINAL): YELLOW INSPECTION COPY (INITIAL): PINK OWNER COPY (INITIAL): GOLD