IREDELL COUNTY HEALTH DEPARTMENT

STATESVILLE 704-878-5305 MOORESVILLE 704-664-5281

IMPROVEMENT PERMIT / AUTHORIZATION TO CONSTRUCT / OPERATION PERMIT / EXISTING SYSTEM INSPECTION

7.00

DATE 1/17/03

PERMIT# Repair PIN# 4646443103 PHONE: Business _____ Home 704-201-6096

OWNER OR CONTRACTOR Kenneth Silver Man

ADDRESS 182 Ponderosa Cir Mooresville NC 28117

LOCATION Williamson Rd, turn on Ponderosa on Rt. 182 Ponderosa Cir

SUBDIVISION Bonanza BLOCK / SECTION _____ LOT 6 LOT AREA _____ SITE CLASS PS DESIGN FLOW 480 L.T.A.R. —

Septic Tank: Existing Gallons; STB _____ Date _____

Pump Tank: _____ Gallons; PT _____ Date _____

Pump Make: _____ Model _____ Serial No. _____

Nitrification Field: No Fields 1 Square Feet 720 Linear Feet 240

No Lines 6@40' Trench Width 36" Max Trench Bottom Depth 24" Gravel Depth —

☐ New System ☒ Repair System Type: I, II, III, IV, V, VI

System Description: _____

Repair System Description: Gravity 25% Reduction

Maintenance Agreement Required: ☐ Yes ☒ No

☒ House/Mod. Home No. Bedrooms 4

☐ Mobile Home No. Bathrooms 2

☐ Business No. Employees _____

☐ Other _____

☐ Slab ☒ Crawl Space ☐ Basement w/plumbing ☐ Basement wo/plumbing


Water Supply: ☐ Individual ☐ Public ☐ Community

Comments:/Conditions:


Drain Field can be fed from either side.

Comments:/Conditions:

INITIAL SITE SKETCH

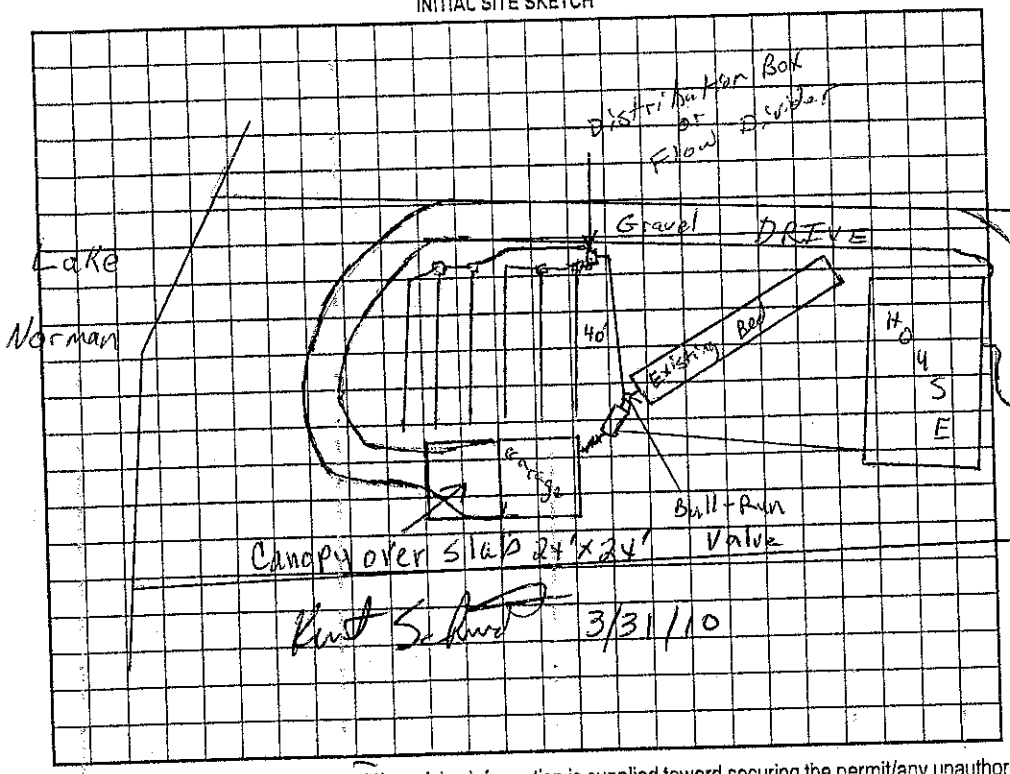

AS BUILT SKETCH

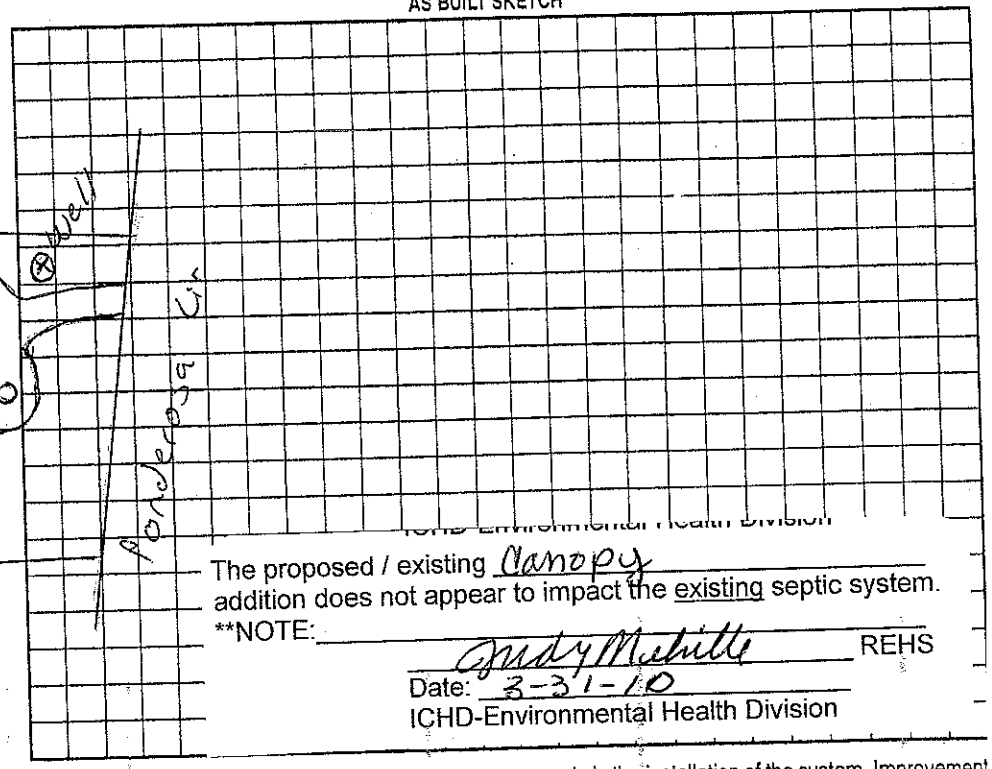

ICHD-Environmental Health Division

The proposed / existing Canopy addition does not appear to impact the existing septic system.

**NOTE: _____

Judy Mabitte REHS

Date: 3-31-10

ICHD-Environmental Health Division

Permit can be suspended or revoked if any false information is supplied toward securing the permit/any unauthorized changes are made to the site/any unauthorized changes are made in the installation of the system. Improvement Permit with plat valid without expiration. Improvement Permit with site plan valid for sixty months. Authorization to Construct is valid for a period equal to that of Improvement Permit – not to exceed sixty months.

Signed: _____ date 1-22-03 Installed by: William Harrington Environmental Solv

Improvement Permit by: _____ RS date 1/17/03 Operation Permit by: _____ RS date 3/14/03

Authorization to Construct by: _____ RS date 1/17/03 Existing System Inspection by: _____ date _____

OWNER COPY (FINAL): YELLOW OWNER COPY (INITIAL): PINK