IREDELL COUNTY HEALTH DEPARTMENT

STATESVILLE 704-878-5305 MOORESVILLE 704-664-5281

IMPROVEMENT PERMIT / AUTHORIZATION TO CONSTRUCT / OPERATION PERMIT / EXISTING SYSTEM INSPECTION

DATE 1-10-08

PERMIT# 1352060 PIN# 4646461118

OWNER OR APPLICANT William & Amanda Hans PHONE: Business 704-645-5356 Home

ADDRESS 340 Weaver Rd China Grove NC 28023

LOCATION Brawley School Rd TL Williamson TR Sundown TL Elysian on right 181

SUBDIVISION Moorelands Est. BLOCK / SECTION LOT 23 LOT AREA .486Ac SITE CLASS PS DESIGN FLOW 480gpd L.T.A.R. .2gpd/ft²

Septic Tank: 1000 Gallons: STB 794 Date

Pump Tank: 1000 Gallons: PT 338 Date

Pump Make: Model Serial No.

Nitrification Field: No Fields 1 Square Feet 1200 Linear Feet 400

No Lines 6 Trench Width 24" min. Max Trench Bottom Depth 30"

☒ New System ☐ Repair ☐ Expansion System Type: I II III IV V VI

System Description: CPPBPS

Repair System Description: max feasible Rule .1945

Maintenance Agreement Required: ☒ Yes ☐ No

Gravel Depth NA ☐ Gravity ☒ Pressure

☒ House/Mod. Home No. Bedrooms 4

☐ Mobile Home No. Persons 8

☐ Business No. Employees

☐ Other


Water Supply: ☒ Individual ☐ Public ☐ Community

☐ Slab ☒ Crawl Space ☐ Basement w/plumbing ☐ Basement wo/plumbing

Comments:/Conditions: Remove surface fill of approx. 3" to 6" Install at max. trench bottom of 30" below natural grade In-line filter in pump tank required


Comments:/Conditions: Lines - 10/8/08

INITIAL SITE SKETCH

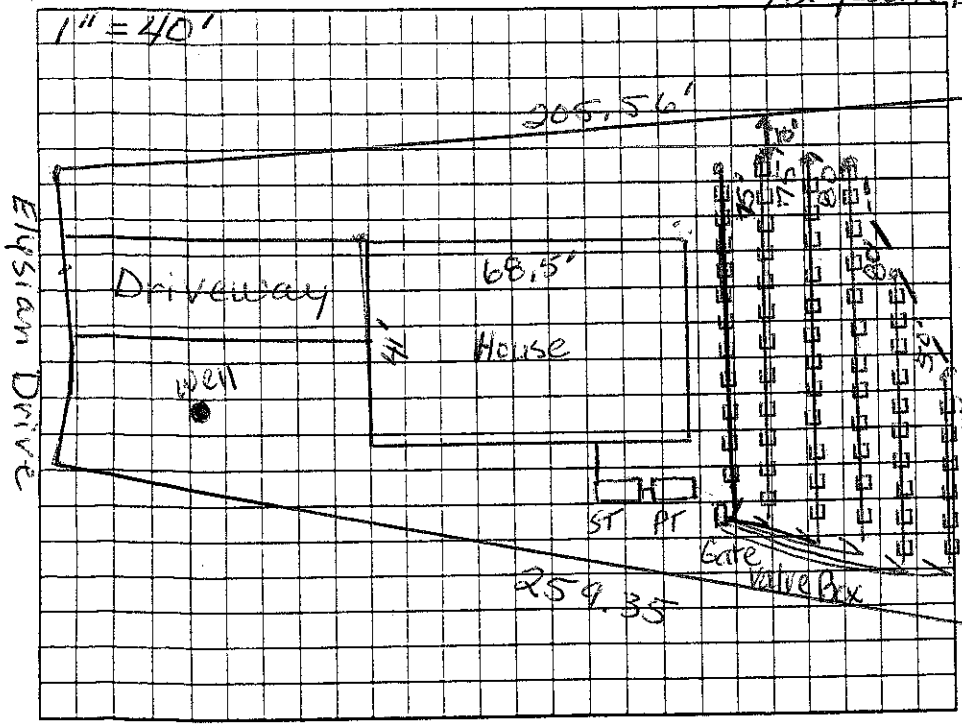

AS BUILT SKETCH

92 panels / 1 hole per panel

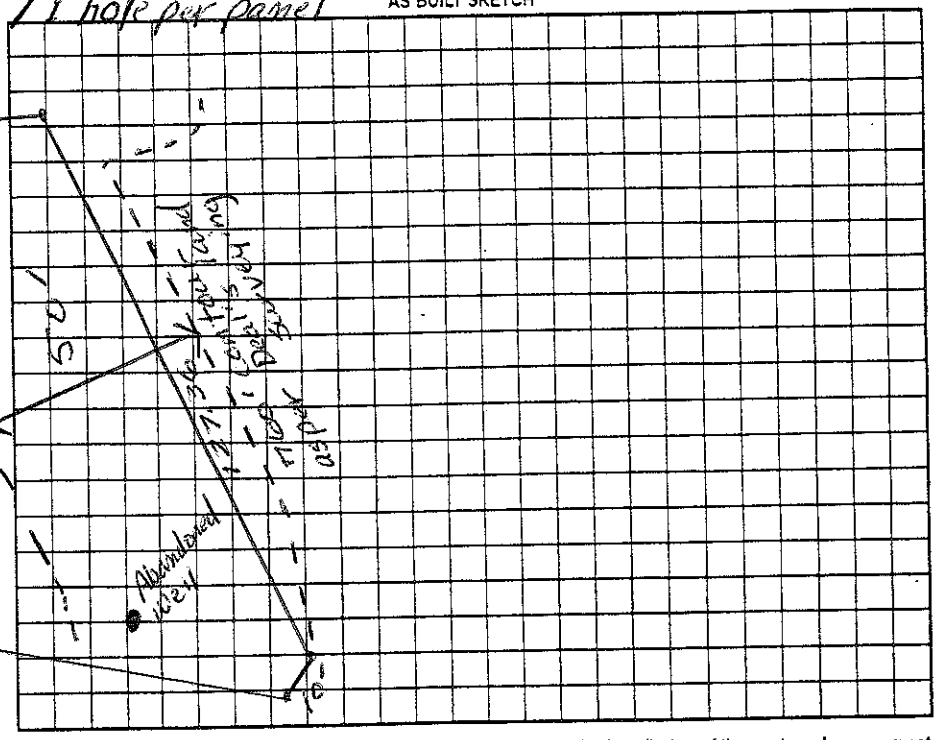

Permit can be suspended or revoked if any false information is supplied toward securing the permit/any unauthorized changes are made to the site/any unauthorized changes are made in the installation of the system. Improvement Permit with plat valid without expiration ☐ Improvement Permit with site plan valid for sixty months ☒ Authorization to Construct is valid for a period equal to that of Improvement Permit – not to exceed sixty months.

Signed: William J Hans date 1-14-08 Installed by: Richard Abernathy

Improvement Permit by: Judy Mebane date 1-10-08 Operation Permit by: Wesley Sparks RS- date 11/12/08

Authorization to Construct by: Judy Mebane date 1-11-08 Existing System Inspection by: date

HEALTH DEPT. COPY: WHITE OWNER COPY (FINAL): YELLOW OWNER COPY (INITIAL): PINK