IREDELL COUNTY HEALTH DEPARTMENT

STATESVILLE 704-878-5305 MOORESVILLE 704-664-5281

IMPROVEMENT PERMIT / AUTHORIZATION TO CONSTRUCT / OPERATION PERMIT / EXISTING SYSTEM INSPECTION

PERMIT# 079049 PIN# 4646 46 1567 DATE 2/15/99

OWNER OR CONTRACTOR Steven Randall Hess PHONE: Business 892-0930 Home

ADDRESS 7510 Woods Lane Cornelius, NC. 28013

LOCATION Williamson Rd TR Sundown TL Blackway TR Elysian Dr. on (L) at intersection of Zephyr Lane

SUBDIVISION Mooreland Est. BLOCK / SECTION LOT 27 LOT AREA ~.5 AC SITE CLASS. PS DESIGN FLOW 360 L.T.A.R. .25

Septic Tank: 1000 Gallons; STB 774 Date 2/8/99
Pump Tank: 1000 Gallons; PT 27 Date 6/4/99
Pump Make: NORWESCO Model Serial No.
Nitrification Field: No Fields 1 Square Feet 720 Linear Feet 240*
No Lines 4 Trench Width 36" Max Trench Bottom Depth 36" Gravel Depth SAND.

[X] New System [ ] Repair System Type: I, II, III, (IV), V, VI
System Description: 16" PPBS (50% reduction)
Repair System Description: Same
Maintenance Agreement Required: [X] Yes [ ] No


[X] House/Mod. Home No. Bedrooms 3
[ ] Mobile Home No. Bathrooms 2
[ ] Business No. Employees
[ ] Other
[ ] Slab [X] Crawl Space [ ] Basement w/plumbing [ ] Basement wo/plumbing

Water Supply: [X] Individual [ ] Public [ ] Community


Comments/Conditions: Variance from DEHNR - Water Supply Branch must be acquired to drill well 25' from 760 Contour line. Maintenance Contract is required

Comments/Conditions: L, I, P

INITIAL SITE SKETCH

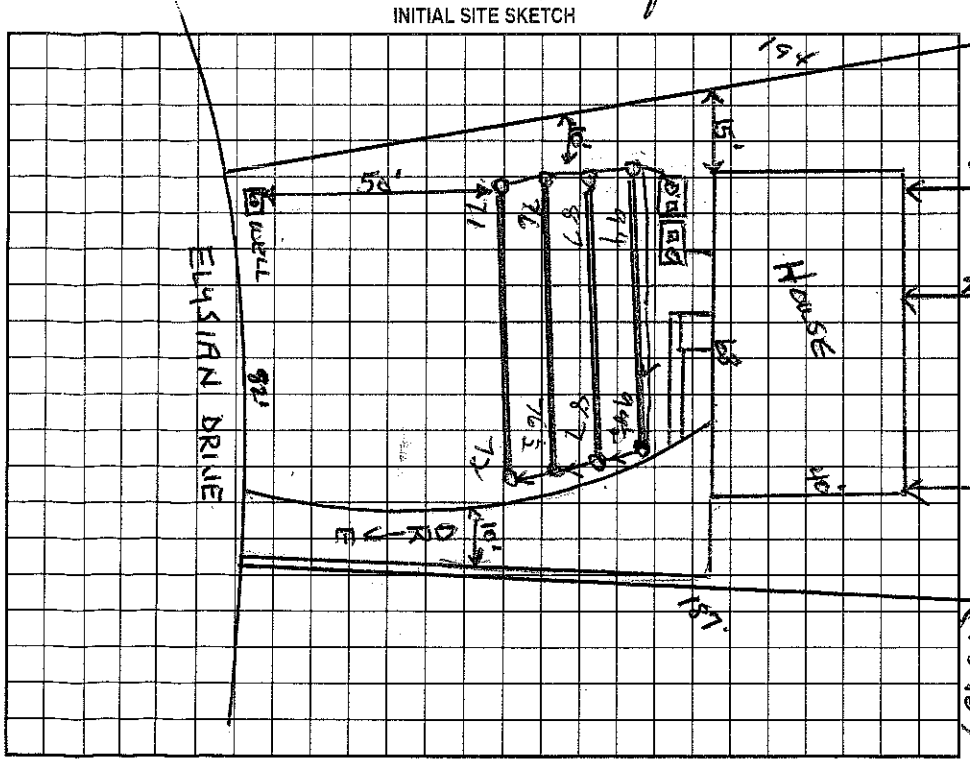

AS BUILT SKETCH

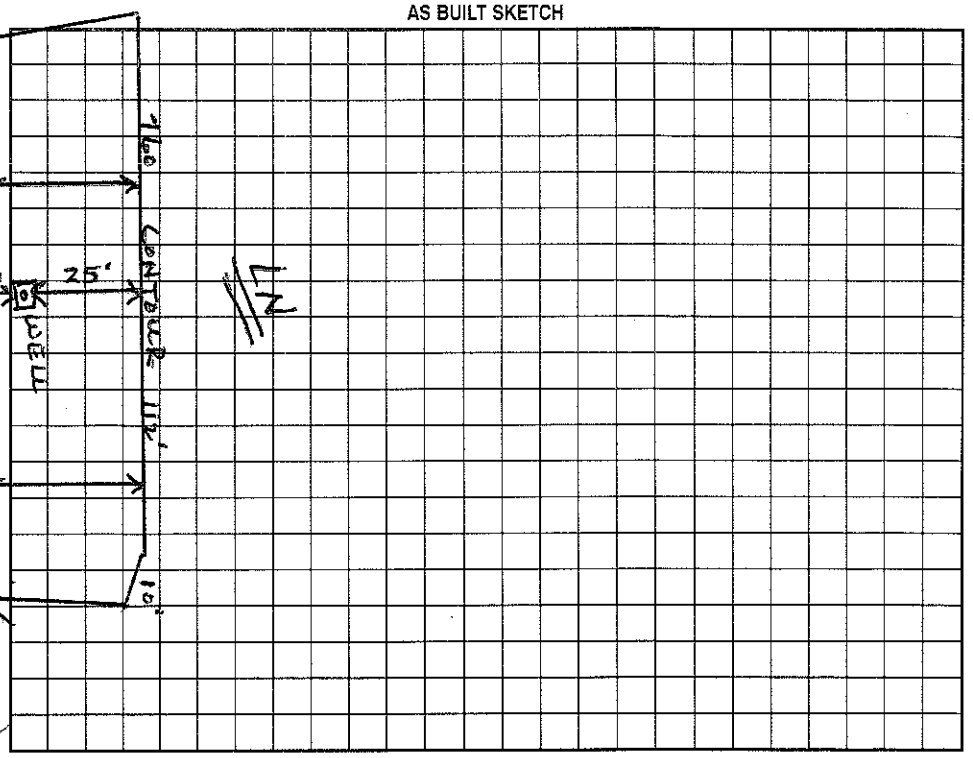

Permit can be suspended or revoked if any false information is supplied toward securing the permit/any unauthorized changes are made to the site/any unauthorized changes are made in the installation of the system. Improvement Permit with plat valid without expiration. Improvement Permit with site plan valid for sixty months. Authorization to Construct is valid for a period equal to that of Improvement Permit – not to exceed sixty months.

Signed: Steven Randall Hess, Jr. date 3/1/99 Installed by: LEVON BENTON

Improvement Permit by: Wesley Sparks RS date 3/1/99 Operation Permit by: Wesley Sparks R.S. date 9/2/99

Authorization to Construct by: Wesley Sparks RS date 3/1/99 Existing System Inspection by: date

HEALTH DEPT. COPY: WHITE OWNER COPY (FINAL): YELLOW OWNER COPY (INITIAL): PINK