OWES $330

IREDELL COUNTY HEALTH DEPARTMENT

STATESVILLE 704-878-5305 MOORESVILLE 704-664-5281

IMPROVEMENT PERMIT / AUTHORIZATION TO CONSTRUCT / OPERATION PERMIT / EXISTING SYSTEM INSPECTION

PERMIT# 138569 PIN# 4646470990 DATE 10/30/06

OWNER OR APPLICANT REBECCA STARNES / JULIE HORTON PHONE: Business 704-00400-0034 Home

ADDRESS 1201 TORRENCE CR DAVIDSON, 28036

LOCATION WILLIAMSON RD, RT SUNDOWN LT BROOKWAY, RT ELYSIAN PROPERTY ON LT

SUBDIVISION IDLEWOOD HARBOR BLOCK / SECTION LOT 74 LOT AREA .537 ACRE SITE CLASS. PS DESIGN FLOW 360gpd L.T.A.R. .30gpd/ft²

Septic Tank: 1000+ Gallons; STB 312 Date 7/9/08

Pump Tank: 1000+ Gallons; PT 283 Date 6/25/08

Pump Make: GOULDS Model PE3SM Serial No. 2108

Nitrification Field: No Fields 1 Square Feet 605 Linear Feet 201

No Lines 3@67' Trench Width 24"/36" Max Trench Bottom Depth 36"

☒ New System ☐ Repair ☐ Expansion System Type: I II III IV V VI

System Description: LP-PANEL

Repair System Description: RE-1983 LOT (EXPIRED)

Maintenance Agreement Required: ☐ Yes ☐ No

☒ House/Mod. Home No. Bedrooms 3

☐ Mobile Home No. Persons

☐ Business No. Employees

☐ Other


Water Supply: ☒ Individual ☐ Public ☐ Community

Gravel Depth N/A ☐ Gravity ☒ Pressure ☐ Slab ☐ Crawl Space ☒ Basement w/plumbing ☐ Basement wo/plumbing

Comments/Conditions: GARAGE IS NOT ON BASEMENT FOUNDATION
- SUPPLY LINE UNDER DRIVE MUST BE AT LEAST 30" DEEP, OR COVERED IN A DUCTILE IRON SLEEVE.

Comments/Conditions: LINES (CAN BE ON 8' MIN. CENTERS)
DRAIN LINES CAN BE 5' OFF PROPERTY LINES IF NEEDED

INITIAL SITE SKETCH

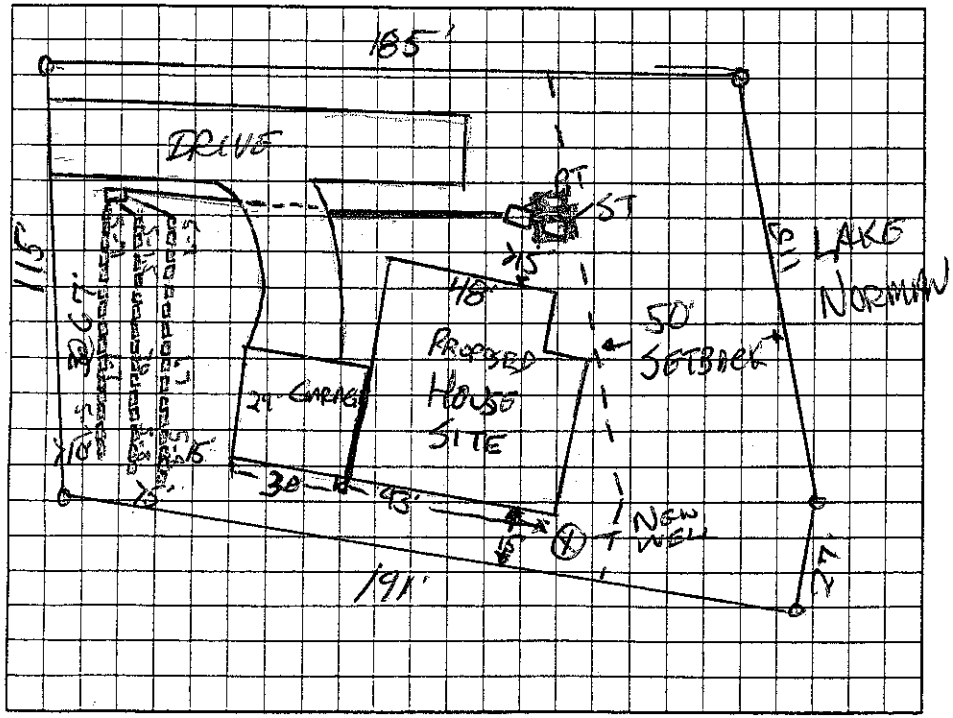

AS BUILT SKETCH

5/32" HOLES - 46 PANELS

Permit can be suspended or revoked if any false information is supplied toward securing the permit/any unauthorized changes are made to the site/any unauthorized changes are made in the installation of the system. Improvement Permit with plat valid without expiration ☐ Improvement Permit with site plan valid for sixty months ☒ Authorization to Construct is valid for a period equal to that of Improvement Permit – not to exceed sixty months.

Signed: Julie A Horton date 11/2/06

Improvement Permit by: Joseph E Alph date 10/31/06

Authorization to Construct by: Joseph E Alph date 10/31/06

Installed by: Richard D Lamontagne

Operation Permit by: Wesley Sparks R.S. date 3/25/09

Existing System Inspection by: date

HEALTH DEPT. COPY: WHITE OWNER COPY (FINAL): YELLOW OWNER COPY (INITIAL): PINK