4646 47 1609

IREDELL COUNTY HEALTH DEPARTMENT

STATESVILLE 704-878-5305 MOORESVILLE 704-664-5281

IMPROVEMENT PERMIT / AUTHORIZATION TO CONSTRUCT / OPERATION PERMIT / EXISTING SYSTEM INSPECTION

PERMIT# 20661 PIN# 2J 5A 38 DATE 8/6/98

OWNER OR CONTRACTOR Chris Billeland PHONE: Business Home 736-1347

ADDRESS 303 N Oak St. Lincolnton, NC. 28092

LOCATION 150 W TL Williamson Rd. TR Sundown Rd. TL Brockway TR Elysian to 8th lot on (L)

SUBDIVISION ~~MOORELAND ESTATES~~ / SECTION LOT ~~58~~ LOT AREA 20,000 FT² SITE CLASS. PS DESIGN FLOW 360 L.T.A.R. , 2

Septic Tank: 1000 Gallons; STB 794 Date 11/16/98
Pump Tank: 1000 Gallons; PT 27 Date 10/19/98
Pump Make: Delta Model WE0511H Serial No. B9833779
Nitrification Field: No Fields 1 Square Feet 900* Linear Feet 300*
No Lines 4 Trench Width 36" Max Trench Bottom Depth 36" Gravel Depth SAND

[X] New System ☐ Repair System Type: I, II, III, IV, V, VI
System Description: LPP-16 PPBS
Repair System Description: SAME
Maintenance Agreement Required: [X] Yes ☐ No

[X] House/Mod. Home No. Bedrooms 3
☐ Mobile Home No. Bathrooms 2
☐ Business No. Employees
☐ Other
☐ Slab ☐ Crawl Space ☐ Basement w/plumbing ☐ Basement wo/plumbing


Water Supply: [X] Individual ☐ Public ☐ Community

Comments:/Conditions: * 50% reduction for 16" Prefab Panel Block Drainfield


~~EDELWOOD HARBOR~~ - ~~Lot 58~~

Comments:/Conditions: Type 4 System.

INITIAL SITE SKETCH Lot 38 Moreland Estates

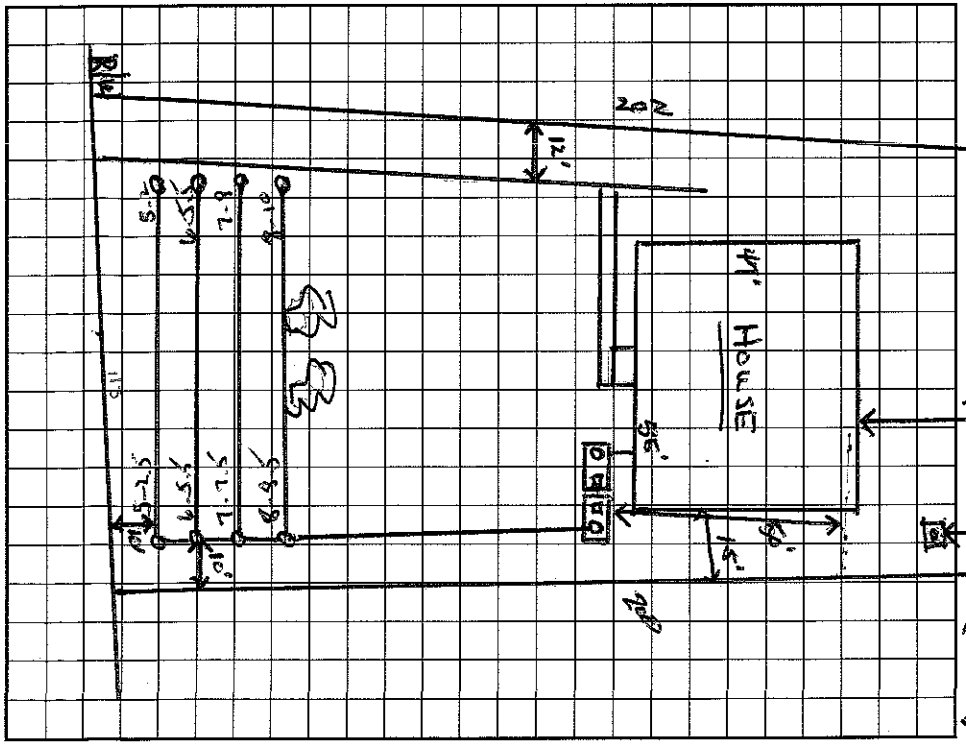

AS BUILT SKETCH

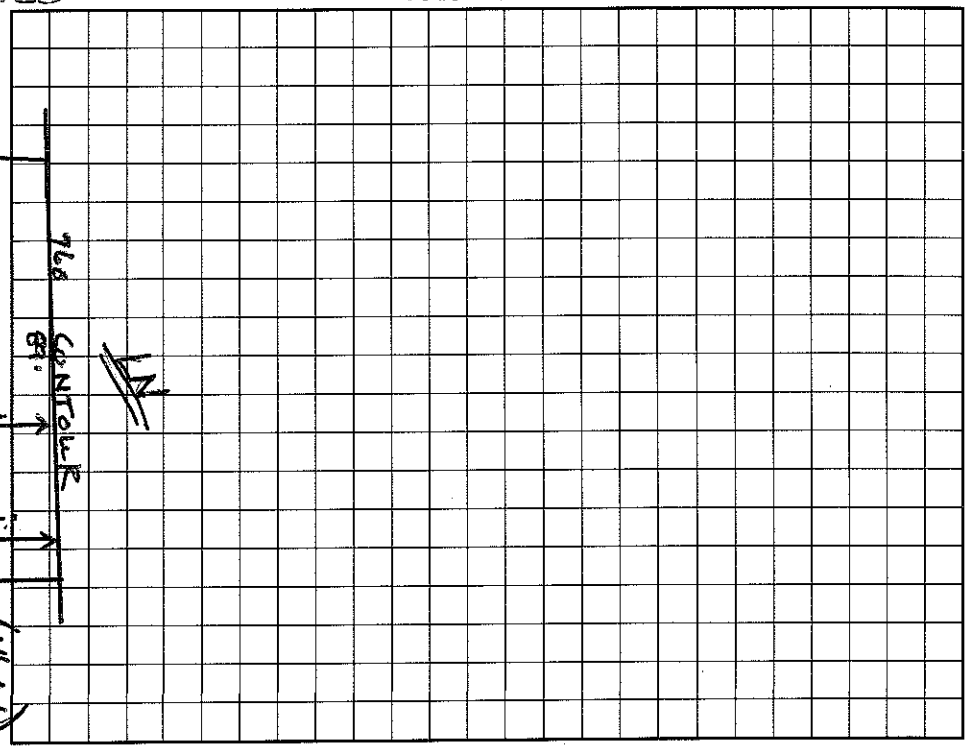

I understand that this permit can be suspended or revoked if any false information is supplied toward securing the permit/any unauthorized changes are made to the site/any unauthorized changes are made in the installation of the system. Improvement Permit with plat valid without expiration. Improvement Permit with site plan valid for sixty months. Authorization to Construct is valid for a period equal to that of Improvement Permit – not to exceed sixty months.

Signed: * [signature] date 8-13-98 Installed by: Denver Plumbing

Improvement Permit by: Wesley Sparks RS. date 8/6/98 Operation Permit by: Wesley Sparks RS. date 12/21/98

Authorization to Construct by: Wesley Sparks RS. date 8/6/98 Existing System Inspection by: date

HEALTH DEPT. COPY: WHITE INSPECTION COPY (FINAL): GREEN OWNER COPY (FINAL): YELLOW INSPECTION COPY (INITIAL): PINK OWNER COPY (INITIAL): GOLD