IREDELL COUNTY HEALTH DEPARTMENT

STATESVILLE 704-878-5305 — Annexed MOORESVILLE 704-664-5281

IMPROVEMENT PERMIT / CERTIFICATE OF COMPLETION / OPERATION PERMIT / EXISTING SYSTEM INSPECTI

PROPERTY DESCRIPTION NO. 15768 DATE MAY 23, '94 TAX MAP NO. 2J 10A 12 4646-47-5818 Watershed: ☑ Yes ☐

OWNER OR CONTRACTOR W. Laird Staley III PHONE: Business 343-2945 Home LV

ADDRESS 1685 Sterling Rd. Charlotte

LOCATION 150W TL SR1109 on Right Approx ¼ mile before 1109 Grill/Restaurant 562 Williamson

SUBDIVISION Idlewood Harbor BLOCK / SECTION ____ LOT 12 LOT AREA 2.100 SITE CLASS. V DESIGN FLOW 360 gpd L.T.A.R. .3

Septic Tank: 1000 Gallons; STB 794 Date 6/21/95
Pump Tank: 1000 Gallons; PT 47 Date 8/25/95
Pump Make: Cowles Model WE0511H Serial No. F9538693
Nitrification Field/ No Fields 2 Square Feet 1200 Linear Feet 400
No Lines 8 Trench Width 36" Max Trench Bottom Depth 24-30" Gravel Depth 21"

☑ New System ☐ Repair System Type: I, II, III, IV, V, VI
System Description: pumped conventional
Repair System Description: SAME
Maintenance Agreement Required: ☐ Yes ☑ No


☑ House/Mod. Home No. Bedrooms 3
☐ Mobile Home No. Bathrooms 4
☐ Business No. Employees ____
☐ Other ____
☐ Slab ☐ Crawl Space ☑ Basement w/plumbing ☐ Basement wo/plumbing

Water Supply: ☑ Individual ☐ Community ☐ Public

Comments: Pump to be sized once p. tank set.

Comments: 400 x .6 = 240 x .66 = 158.4 ÷ 20 = 7.9" Drawdown / Dose

INITIAL SITE SKETCH

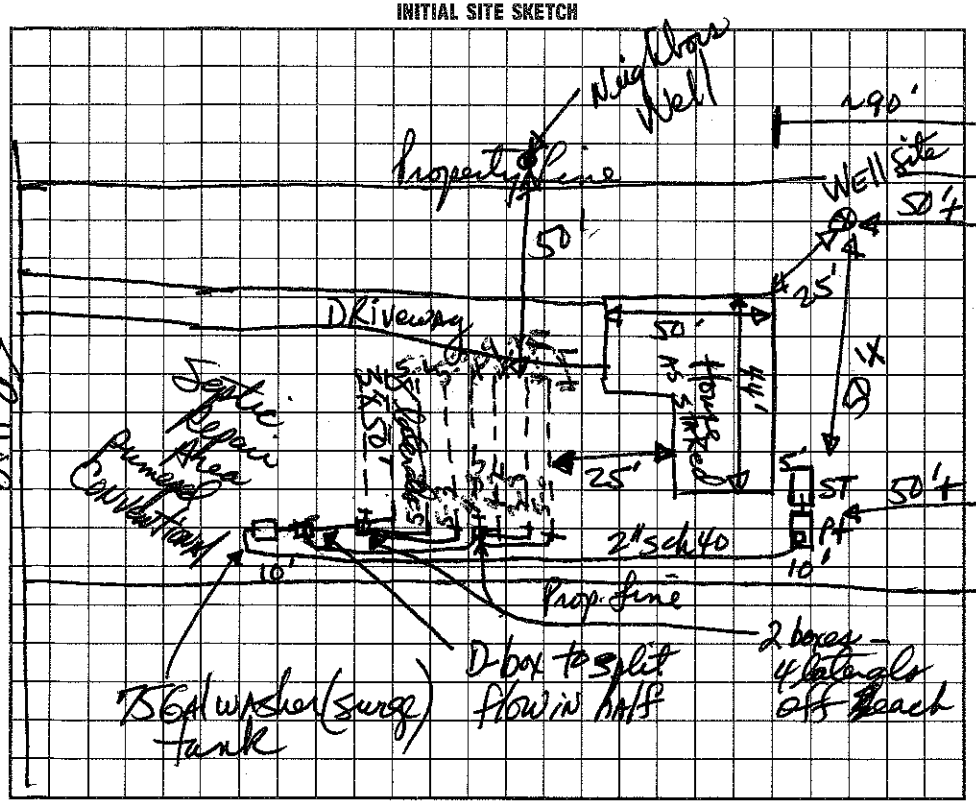

AS BUILT SKETCH

I understand that this permit can be suspended or revoked if any false information is supplied toward securing the permit/any unauthorized changes are made to the site/any unauthorized changes are made in the installation of the system. Improvement Permit is valid for 60 months from date of issuance.

Signed: [signature]

Improvement Permit by: James R. Emerson, RS date 5/23/94

Existing System Inspection by: ____ date ____

Installed by: F J Erwin

Certificate of Completion by: ____ date ____

Operation Permit by: Wesley Sparks RS. date 10/3/95

HEALTH DEPT. COPY: WHITE — INSPECTION COPY (FINAL): GREEN — OWNER COPY (FINAL): YELLOW — INSPECTION COPY (INITIAL): PINK — OWNER COPY (INITIAL): GOLD