1164450

IREDELL COUNTY HEALTH DEPARTMENT

STATESVILLE 704-878-5305 325.00 Paid MOORESVILLE 704-664-5281

IMPROVEMENT PERMIT / AUTHORIZATION TO CONSTRUCT / OPERATION PERMIT / EXISTING SYSTEM INSPECTION

PERMIT# 2255 Mesvl. PIN# ~~4645-59-2250~~ 4646-50-0470 DATE Dec. 14, 01

OWNER OR CONTRACTOR Dienst Enterprises Inc. / ST LAWRENCE HOMES PHONE: Business _____ Home _____

ADDRESS 125 Easton Dr. Mooresville 28117

LOCATION 215 TR Alcove TR Templeton TR Templeton Bay on Right near cul-de-sac end

SUBDIVISION Templeton Bay BLOCK / SECTION _____ LOT 44 LOT AREA 28727 ft² SITE CLASS. PS DESIGN FLOW 480 gpd L.T.A.R. .25

Septic Tank: 1000 Gallons; STB 312 Date 12-14-03

Pump Tank: 1000 Gallons; PT 27 Date 12-14-03

Pump Make: Meyers Model ME50 Serial No. _____

Nitrification Field: No. Fields 1 Square Feet 640/960 Linear Feet 320

No Lines 4@80 Trench Width 24" min 30" Max Trench Bottom Depth 36" Gravel Depth N/A

☑ New System ☐ Repair System Type: I. II. III. IV. V. VI

System Description: LPPBPS

Repair System Description: SAME

Maintenance Agreement Required: ☑ Yes ☐ No

☑ House/Mod. Home ☐ Mobile Home ☐ Business ☐ Other

No. Bedrooms 4 No. Bathrooms 4 No. Employees _____

Water Supply: ☐ Individual ☑ ~~Public~~ ☑ Community

☐ Slab ☑ Crawl Space ☐ Basement w/plumbing ☐ Basement wo/plumbing


Comments/Conditions: OR 36" MAX @ 80' Do not cut house site; Backfill against foundation as needed in order to provide positive drainage. Remove any old burns in septic system area.

Comments/Conditions: Checked tanks & lines 1/22/04 Checked pressure, elect & alarm 2/4/04 Maint agreement 2/10/04

1"=50'

INITIAL SITE SKETCH

*Skipped these 2 lines because of big trees (use area for Repair)

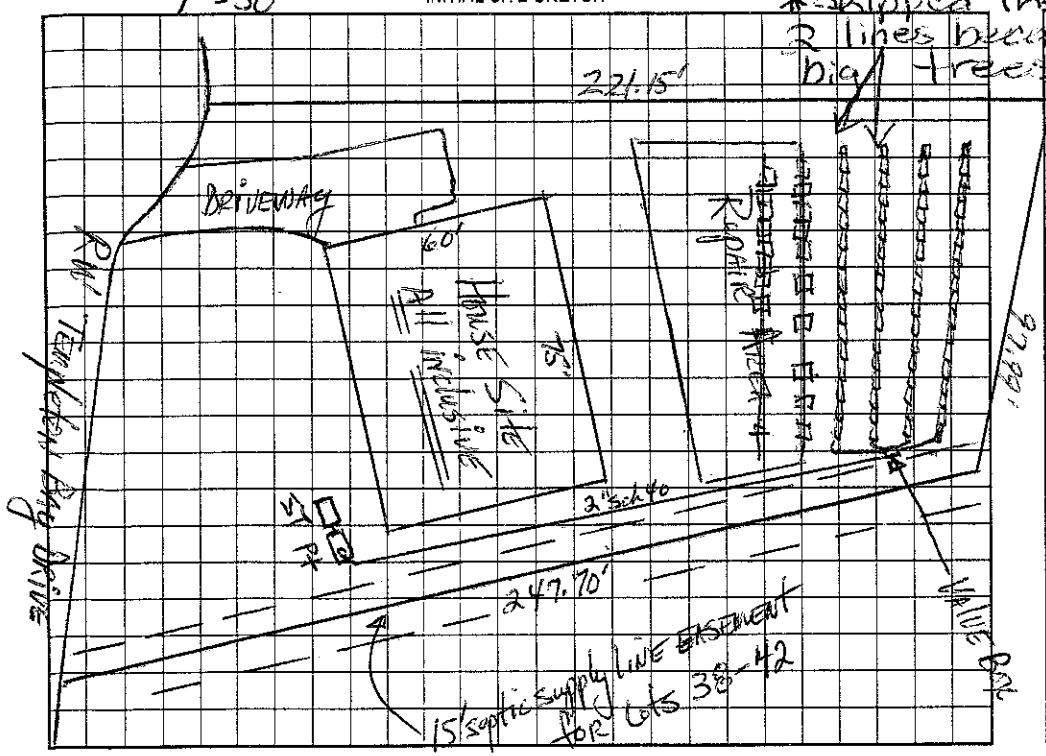

AS BUILT SKETCH

Permit can be suspended or revoked if any false information is supplied toward securing the permit/any unauthorized changes are made to the site/any unauthorized changes are made in the installation of the system. Improvement Permit with plat valid without expiration. Improvement Permit with site plan valid for sixty months. Authorization to Construct is valid for a period equal to that of Improvement Permit – not to exceed sixty months.

Signed: Robert R. Dienst date 11/29/02

Improvement Permit by: [signature] RS date 12-14-01

Authorization to Construct by: [signature] date 10/9/03

Installed by: K & H

Operation Permit by: [signature] RS date 2/11/04

Existing System Inspection by: _____ date _____

HEALTH DEPT. COPY: WHITE OWNER COPY (FINAL): YELLOW OWNER COPY (INITIAL): PINK