IREDELL COUNTY HEALTH DEPARTMENT

STATESVILLE 704-878-5305 325.00 Paid MOORESVILLE 704-664-5281

IMPROVEMENT PERMIT / AUTHORIZATION TO CONSTRUCT / OPERATION PERMIT / EXISTING SYSTEM INSPECTI

PERMIT# 225 MRSid 119641 PIN# 4645-59-2290 ~~Susan Mead~~ 4646-50-0563 DATE Dec. 13, 01

OWNER OR CONTRACTOR Quest Enterprises Inc. / St. Lawrence Homes PHONE: Business 210 Templeton Bay Home 663-3593

ADDRESS 125 Easten Dr. Mooresville N.C. 28117

LOCATION 215 TR Alcove TR Templeton TR Templeton Bay At End on Right 210

SUBDIVISION Templeton Bay BLOCK / SECTION _____ LOT 43 LOT AREA 32,252 ft² SITE CLASS. RS 1956 DESIGN FLOW 480 L.T.A.R. .3

Septic Tank: 1000 Gallons; STB 312 Date 7-1-04
Pump Tank: 1000 Gallons; PT 27 Date 7-6-04
Pump Make: Myers Model ME 50 Serial No. _____
Nitrification Field: No Fields 1 Square Feet 560/840 Linear Feet 280
No Lines 4@70 Trench Width 24" min 36" Max Trench Bottom Depth 36" Gravel Depth NA

☐ New System ☐ Repair System Type: I. II. III. IV. V. VI
System Description: CPPBPS
Repair System Description: SAME
Maintenance Agreement Required: ☑ Yes ☐ No

☐ House/Mod. Home No. Bedrooms 4
☐ Mobile Home No. Bathrooms 4
☐ Business No. Employees _____
☐ Other _____

☐ Slab ☑ Crawl Space ☐ Basement w/plumbing ☐ Basement wo/plumbing


Water Supply: ☐ Individual ☐ Public ☐ Community

Comments:/Conditions: or 36" max 90c
Do Not cut house site. Backfill against foundation as needed in order to provide positive drainage. Remove any old burn in septic system area.


Comments:/Conditions: Note: Switched Repair area & Initial area
Checked tanks & lines 8/20/04. MD

INITIAL SITE SKETCH

1" = 50'

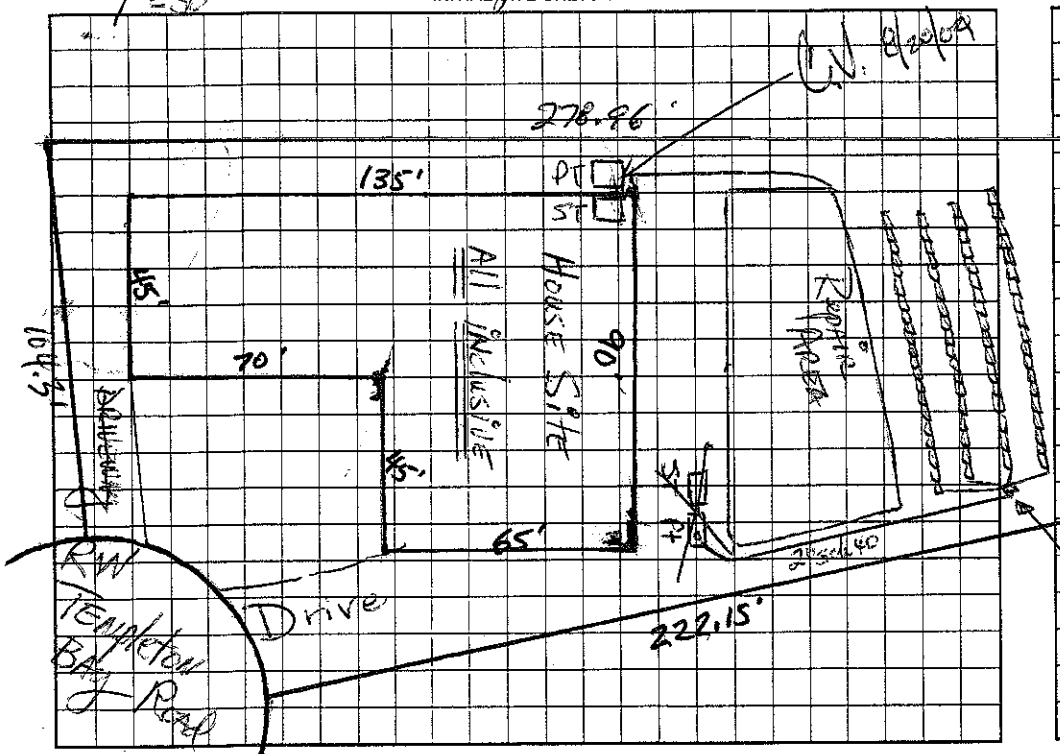

AS BUILT SKETCH

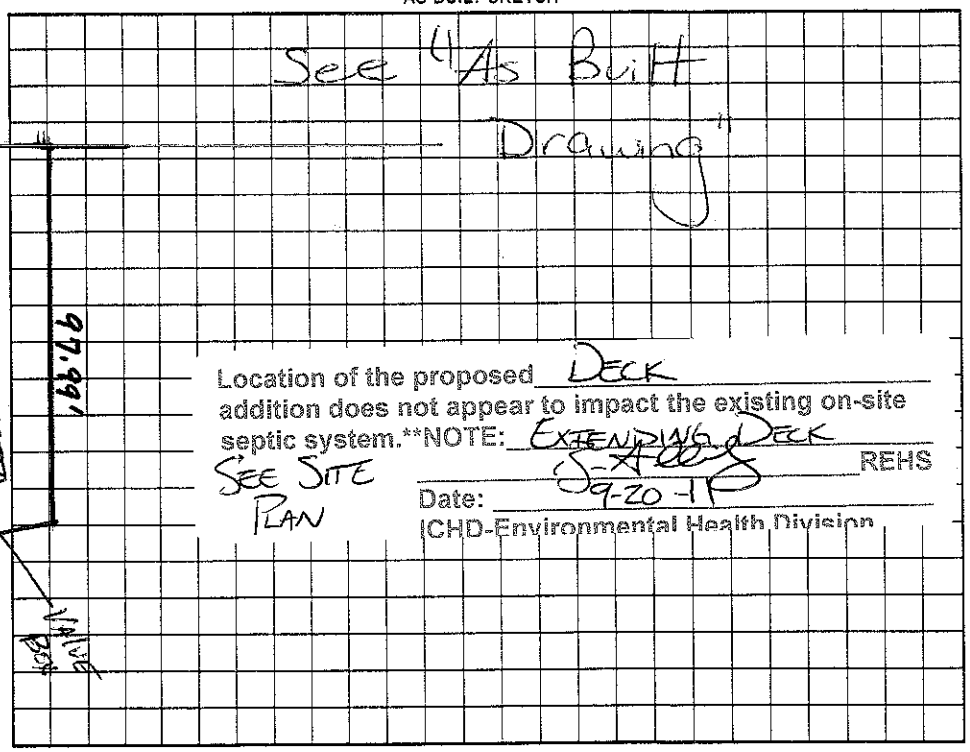

Location of the proposed Deck addition does not appear to impact the existing on-site septic system.**NOTE: Extending Deck See Site Plan

REHS


CHD-Environmental Health Division

Permit can be suspended or revoked if any false information is supplied toward securing the permit/any unauthorized changes are made to the site/any unauthorized changes are made in the installation of the system. Improvement Permit with plat valid without expiration. Improvement Permit with site plan valid for sixty months. Authorization to Construct is valid for a period equal to that of Improvement Permit – not to exceed sixty months.

Signed: Robert B. Dixon date 1/29/02

Improvement Permit by: _____ RS date 12-13-01

Authorization to Construct by: _____ RS date 3/16/04

Installed by: _____

Operation Permit by: Marvin H. Dotson RS date 8/24/04

Existing System Inspection by: _____ date _____

HEALTH DEPT. COPY: WHITE OWNER COPY (FINAL): YELLOW OWNER COPY (INITIAL): PINK