IREDELL COUNTY HEALTH DEPARTMENT

STATESVILLE 704-878-5305 325.00 Paid MOORESVILLE 704-664-5281 1030

IMPROVEMENT PERMIT / AUTHORIZATION TO CONSTRUCT / OPERATION PERMIT / EXISTING SYSTEM INSPECTI

PERMIT# 225 Mrsvl.119641 PIN# 4645-59-2220 Susan Mead 4646-50-0563 DATE Dec. 13, 01

OWNER OR CONTRACTOR Jenst Enterprises Inc. / St. Lawrence Homes PHONE: Business 210 Templeton Bay Home 663-3593

ADDRESS 125 Easton Dr. Mooresville N.C. 28117

LOCATION 215 TR Alcove TR Templeton TR Templeton Bay at end on Right 210

SUBDIVISION Templeton Bay BLOCK / SECTION ____ LOT 43 LOT AREA 32,252 ft² SITE CLASS. RS 1956 DESIGN FLOW 480 L.T.A.R. .3

Septic Tank: 1000 Gallons; STB 312 Date 7-11-04

Pump Tank: 1000 Gallons; PT 27 Date 7-6-04

Pump Make: Myers Model ME 50 Serial No. ____

Nitrification Field: No Fields 1 Square Feet 560/840 Linear Feet 280

No Lines 4@70 Trench Width 24" min 36" Max Trench Bottom Depth 36" Gravel Depth NA

☐ New System ☐ Repair System Type: I, II, III, IV, V, VI

System Description: CPPBPS

Repair System Description: SAME

Maintenance Agreement Required: ☑ Yes ☐ No

☐ House/Mod. Home No. Bedrooms 4

☐ Mobile Home No. Bathrooms 4

☐ Business No. Employees ____

☐ Other ____

☐ Slab ☑ Crawl Space ☐ Basement w/plumbing ☐ Basement wo/plumbing

Water Supply: ☐ Individual ☐ Public ☐ Community

Comments:/Conditions: or 36" max 90c


Do not cut house site. Backfill against foundation as needed in order to provide positive drainage. Remove any old burn in septic system area.

Comments:/Conditions: Note: Switched Repair area & Initial area

Checked tanks & lines 8/20/04. MD

INITIAL SITE SKETCH

1" = 50'

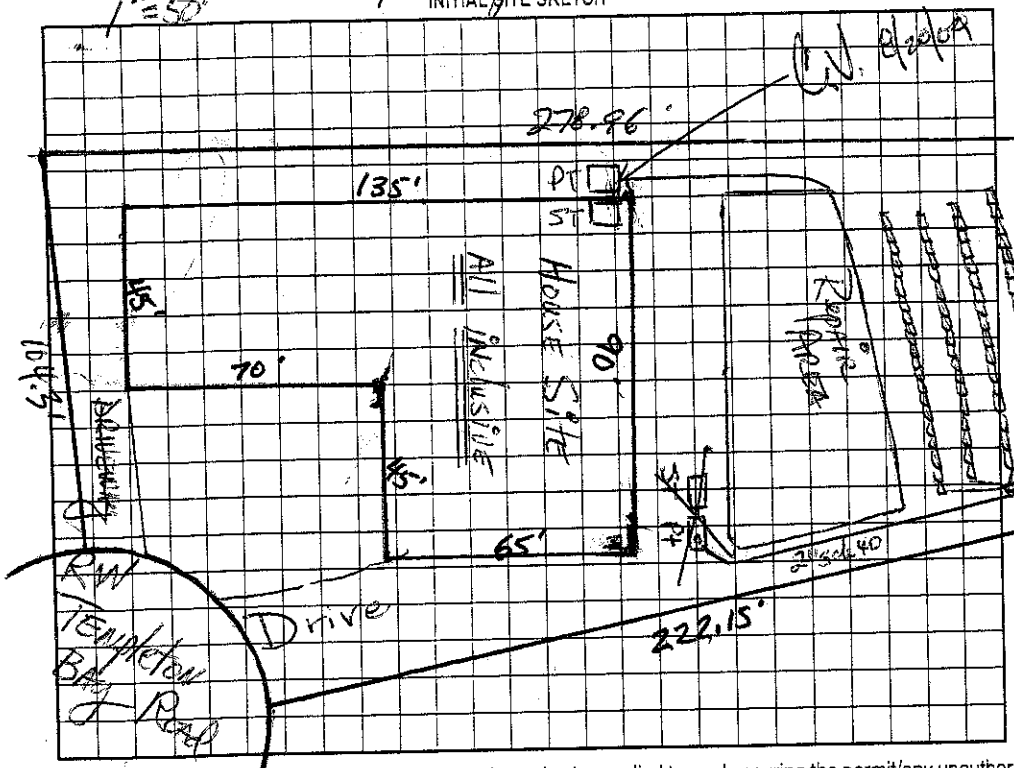

AS BUILT SKETCH

See "As Built" Drawing

Location of the proposed Deck addition does not appear to impact the existing on-site septic system.**NOTE: Extending Deck See Site Plan

REHS

Date: 9-20-04

ICHD-Environmental Health Division

Permit can be suspended or revoked if any false information is supplied toward securing the permit/any unauthorized changes are made to the site/any unauthorized changes are made in the installation of the system. Improvement Permit with plat valid without expiration. Improvement Permit with site plan valid for sixty months. Authorization to Construct is valid for a period equal to that of Improvement Permit – not to exceed sixty months.

Signed: Robert B. Strand date 1/29/02

Improvement Permit by: [signature] RS date 12-13-01

Authorization to Construct by: [signature] RS date 3/16/04

Installed by: [signature] RS

Operation Permit by: [signature] RS date 8/24/04

Existing System Inspection by: ____ date ____

HEALTH DEPT. COPY: WHITE OWNER COPY (FINAL): YELLOW OWNER COPY (INITIAL): PINK