IREDELL COUNTY HEALTH DEPARTMENT

STATESVILLE 704-878-5305 MOORESVILLE 704-664-5281

IMPROVEMENT PERMIT / AUTHORIZATION TO CONSTRUCT / OPERATION PERMIT / EXISTING SYSTEM INSPECTION

PERMIT# 074436 PIN# ~~4646-52-3303~~ 4646-52-2130 DATE 7/23/98

OWNER OR CONTRACTOR FRANK SHAVER PHONE: Business Home 664-7674

ADDRESS 180 CATALINA RD MOORESVILLE NC

LOCATION ALCOVE - JR CATALINA - ON RT B-4 KNOX HAVEN

SUBDIVISION — BLOCK / SECTION — LOT 6 LOT AREA .2 SITE CLASS. ES DESIGN FLOW 360 L.T.A.R. .3

Septic Tank: 1000 Gallons; STB 1012 Date 6/1/98

Pump Tank: Gallons; PT Date

Pump Make: Model Serial No.

Nitrification Field: No Fields 1 Square Feet 900 Linear Feet 300

No Lines 3@100' Trench Width 36" Max Trench Bottom Depth 36" Gravel Depth N/A

☑ New System ☐ Repair System Type: I, II, III, IV, V, VI

System Description: GRAVITY CHAMBERS OR HDPE

Repair System Description: SAME

Maintenance Agreement Required: ☐ Yes ☑ No

☐ House/Mod. Home ☑ Mobile Home ☐ Business ☐ Other

No. Bedrooms 3 No. Bathrooms 2 No. Employees


☐ Slab ☑ Crawl Space ☐ Basement w/plumbing ☐ Basement wo/plumbing

Water Supply: ☑ Individual ☐ Public ☐ Community


Comments:/Conditions:

Comments:/Conditions:

INITIAL SITE SKETCH

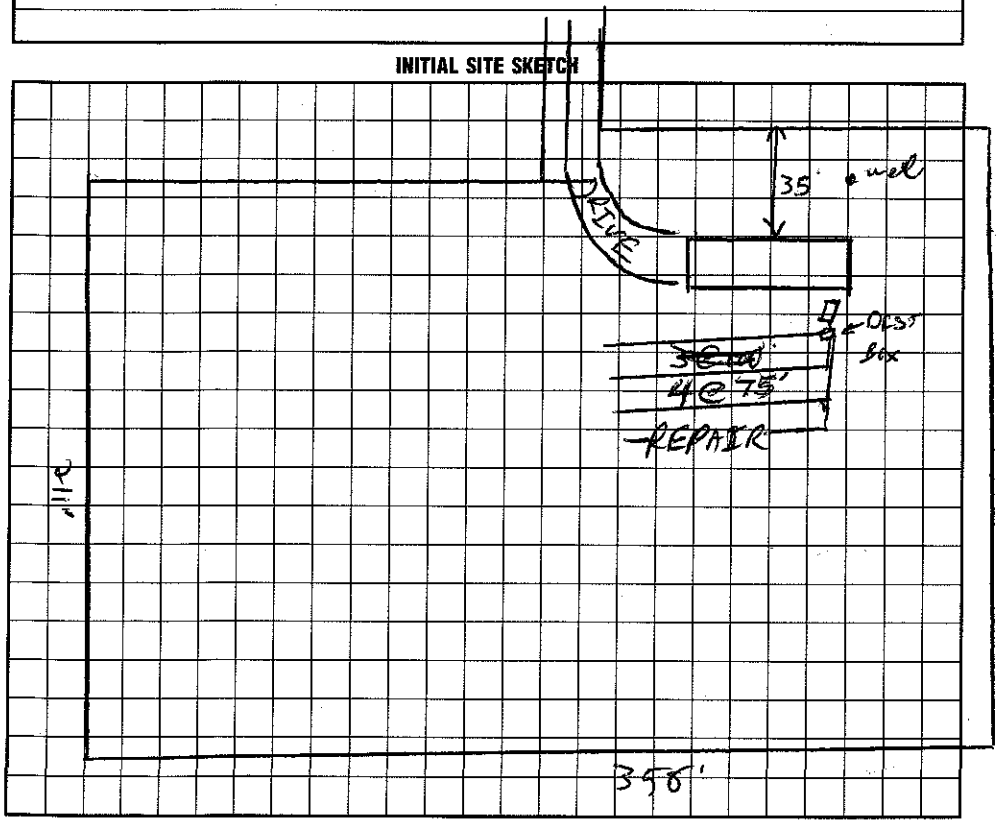

AS BUILT SKETCH

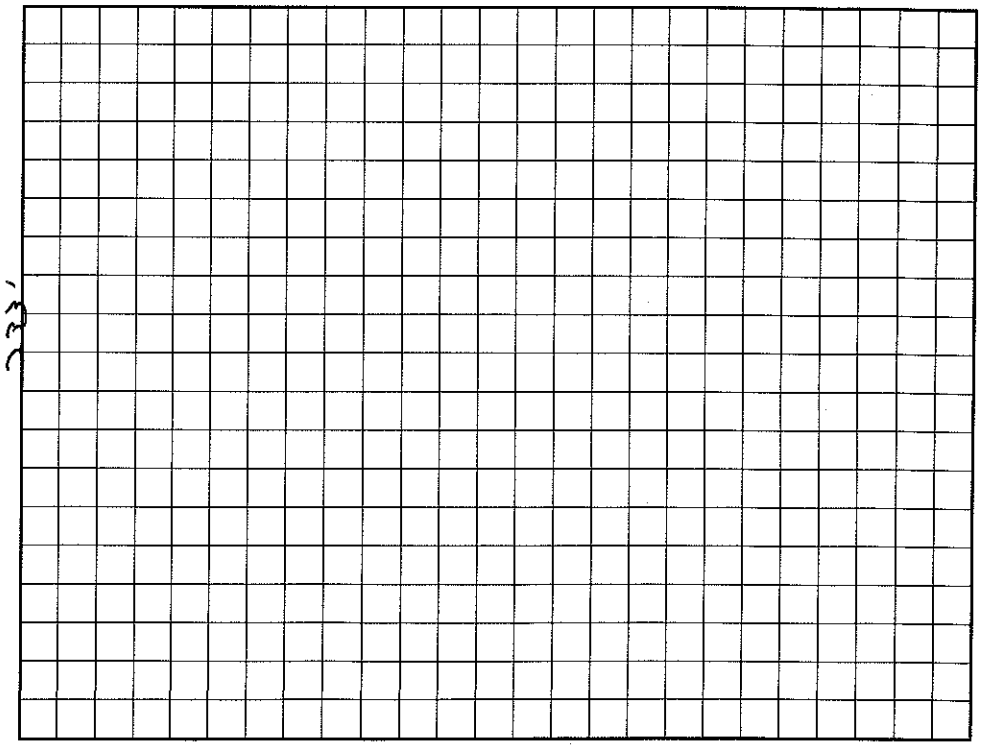

I understand that this permit can be suspended or revoked if any false information is supplied toward securing the permit/any unauthorized changes are made to the site/any unauthorized changes are made in the installation of the system. Improvement Permit with plat valid without expiration. Improvement Permit with site plan valid for sixty months. Authorization to Construct is valid for a period equal to that of Improvement Permit – not to exceed sixty months.

Signed: David Robert date

Improvement Permit by: C. Alyson Thomas ES date 7/23/98

Authorization to Construct by: C. Alyson Thomas ES date 7/23/98

Installed by: A-1 BACKHOE

Operation Permit by: C. Alyson Thomas ES date 7/30/98

Existing System Inspection by: date

HEALTH DEPT. COPY: WHITE INSPECTION COPY (FINAL): GREEN OWNER COPY (FINAL): YELLOW INSPECTION COPY (INITIAL): PINK OWNER COPY (INITIAL): GOLD