4646-64-4962 55-8115

IREDELL COUNTY HEALTH DEPARTMENT

STATESVILLE 704-878-5305 MOORESVILLE 704-664-5281

IMPROVEMENT PERMIT / CERTIFICATE OF COMPLETION / OPERATION PERMIT / EXISTING SYSTEM INSPECTION

PROPERTY DESCRIPTION NO. 16244 DATE 6/11/93 TAX MAP NO. 2J 6A 3

OWNER OR CONTRACTOR KAREN HAGER PHONE: Business Home 663-4165

ADDRESS Rt 11 Box 1437 MOORESVILLE, NC.

LOCATION ALCOVE N, TO COBBLER COVE, R ON DIRT DRIVE TO FIRST TRAILER ON L

SUBDIVISION HAGERS PT BLOCK / SECTION LOT 3 LOT AREA EXISTING SITE CLASS. P L.T.A.R. .3

Water Supply: ☑ Individual ☐ Community ☐ Public

Septic Tank: EXISTING Gallons; STB Date

Pump Tank: Gallons; PT Date

Nitrification Field: No Fields 1 Square Feet 515 Linear Feet ~240

No Lines 3 Trench Width 7.5' Trench Depth 36" Gravel Depth 12"

☐ New System ☐ Repair System Type: I, II, III, IV, V, VI

System Description: ENSTING - CONV.

Repair System Description:

Maintenance Agreement Required: ☐ Yes ☑ No

☐ House/Mod. Home ☑ Mobile Home ☐ Business ☐ Other

No. Bedrooms 2 No. Bathrooms 2 No. Employees

Garbage Disposal: ☐ Yes ☑ No

Auto. Dishwasher: ☑ Yes ☐ No

Auto. Washing Machine: ☑ Yes ☐ No

Other


☐ Slab ☑ Crawl Space ☐ Basement w/plumbing ☐ Basement wo/plumbing

Comments 2 TRAILERS TO BE REMOVED - ONE NEW TRAILER TO BE PUT BACK.

Site Address - 106 Cobbler Cove Rd

INITIAL SITE SKETCH

AS BUILT SKETCH

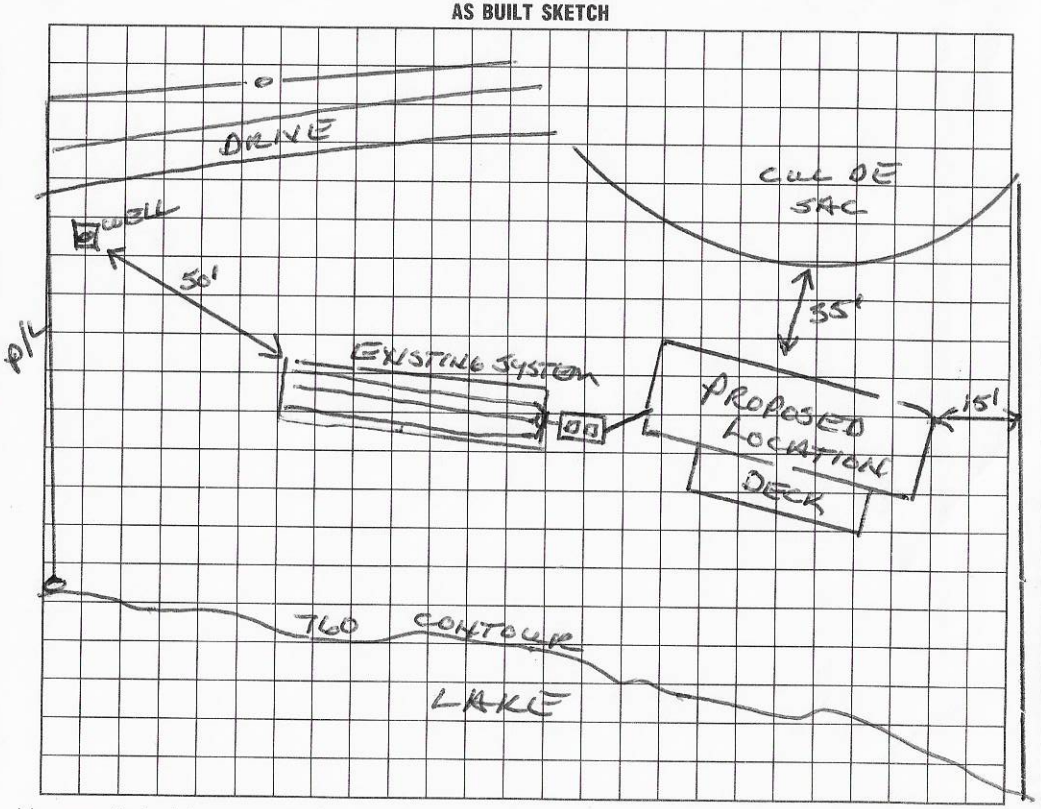

I understand that this permit can be suspended or revoked if any false information is supplied toward securing the permit/any unauthorized changes are made to the site/any unauthorized changes are made in the installation of the system. Improvement Permit is valid for 60 months from date of issuance.

Signed:

Improvement Permit by: date

Existing System Inspection by: Wesley Sparks RS. date 6/11/93

Installed by:

Certificate of Completion by: date

Operation Permit by: date

HEALTH DEPT. COPY: WHITE INSPECTION COPY (FINAL): GREEN OWNER COPY (FINAL): YELLOW INSPECTION COPY (INITIAL): PINK OWNER COPY (INITIAL): GOLD