IREDELL COUNTY HEALTH DEPARTMENT

STATESVILLE 704-878-5305 MOORESVILLE 704-664-5281

IMPROVEMENT PERMIT / AUTHORIZATION TO CONSTRUCT / OPERATION PERMIT / EXISTING SYSTEM INSPECTION

5/5,00 Eq. 4

PERMIT# 119695 PIN# 4646 64 0992 DATE 9/8/04

OWNER OR CONTRACTOR Bryant Hager PHONE: Business 704-663-2936 Home

ADDRESS 758 Akers Rd. Mooresville, NC. 28117

LOCATION Williamson Rd, to Akers Rd, around sharp curve, immediately on (R)

SUBDIVISION NO BLOCK / SECTION LOT LOT AREA SITE CLASS. DESIGN FLOW 360 L.T.A.R. 3

Septic Tank: 1000 Gallons; STB 794 Date 1/11/05
Pump Tank: 1000 Gallons; PT 27 Date 1/15/05
Pump Make: MYERS Model ME-50 Serial No.
Nitrification Field: No Fields 1 Square Feet 400/600 Linear Feet 200
No Lines 4@50' Trench Width 2-3' Max Trench Bottom Depth 3' Gravel Depth NO

☒ New System ☐ Repair System Type: I, II, III, IV, V, VI
System Description: Pres Dosed - 16" PPBIPS
Repair System Description: SAME
Maintenance Agreement Required: ☒ Yes ☐ No


☒ House/Mod. Home No. Bedrooms 3
☐ Mobile Home No. Bathrooms 3
☐ Business No. Employees
☐ Other
☐ Slab ☒ Crawl Space ☐ Basement w/plumbing ☐ Basement wo/plumbing

Water Supply:
☒ Individual
☐ Public
☐ Community
SHARED

Comments:/Conditions:
LN
760 CONTOUR

Comments:/Conditions:

INITIAL SITE SKETCH

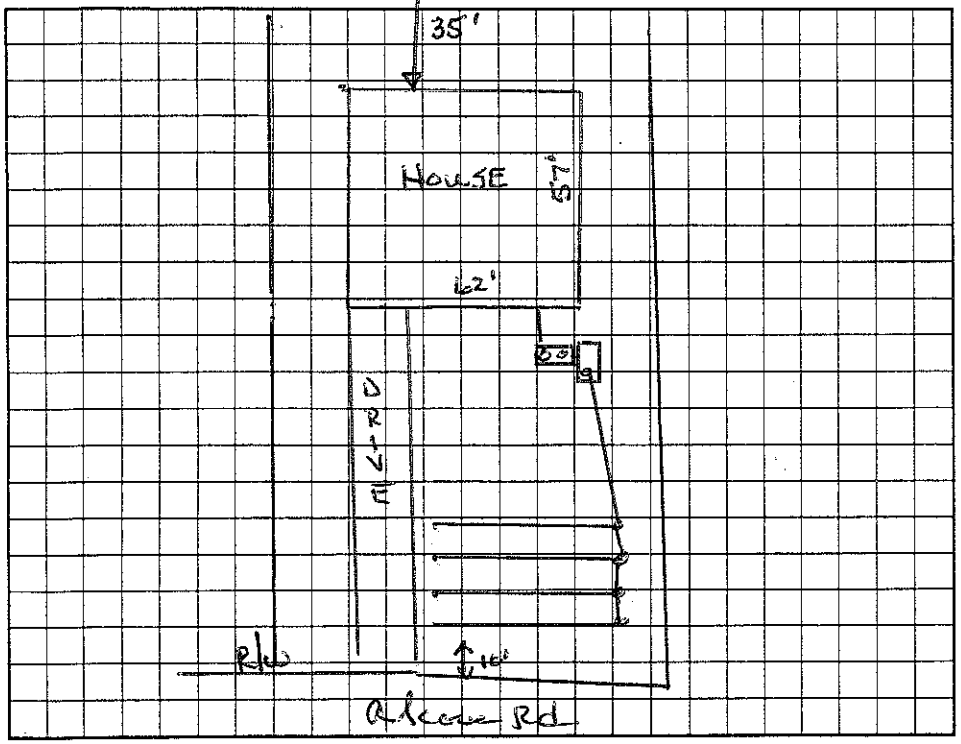

AS BUILT SKETCH

Permit can be suspended or revoked if any false information is supplied toward securing the permit/any unauthorized changes are made to the site/any unauthorized changes are made in the installation of the system. Improvement Permit with plat valid without expiration. Improvement Permit with site plan valid for sixty months. Authorization to Construct is valid for a period equal to that of Improvement Permit – not to exceed sixty months.

Signed: X date 9-8-04 Installed by: Propst Landscaping + Septic

Improvement Permit by: Wesley Sparks RS. date 9/8/04 Operation Permit by: Wesley Sparks RS. date 3/1/05

Authorization to Construct by: Wesley Sparks RS date 9/8/04 Existing System Inspection by: date

HEALTH DEPT. COPY: WHITE OWNER COPY (FINAL): YELLOW OWNER COPY (INITIAL): PINK