Site address: 513 Bridgewater Dr (formerly Alcove) - Misc. 4646-64-1864

IREDELL COUNTY HEALTH DEPARTMENT

STATESVILLE 704-878-5305 64-3938 MOORESVILLE 704-664-5281

IMPROVEMENT PERMIT / CERTIFICATE OF COMPLETION / OPERATION PERMIT / EXISTING SYSTEM INSPECTION

PROPERTY DESCRIPTION NO. 16839 DATE 8/20/93 TAX MAP NO. 2J 72 A 18 6B 7

OWNER OR CONTRACTOR HAGERS MH PARK (RALPH CRAWFORD) PHONE: Business _____ Home 664-9732

ADDRESS ALCOVE RD. SR 1206 AROUND SHARP (L) CURVE TO 2ND TRAILER ON (L)

LOCATION ALCOVE RD. - LAKEVIEW

SUBDIVISION HAGERS POINT BLOCK / SECTION B LOT 7 LOT AREA EXISTING SITE CLASS. P L.T.A.R. _____

Water Supply: ☐ Individual ☑ Community ☐ Public

Septic Tank: EXISTING Gallons; STB _____ Date _____

Pump Tank: _____ Gallons; PT _____ Date _____

Nitrification Field: No Fields EXIST/Solid Feet _____ Linear Feet _____

No Lines _____ Trench Width _____ Trench Depth _____ Gravel Depth _____

☐ New System ☐ Repair System Type: I (II) III, IV, V, VI

System Description: CONV.

Repair System Description: _____

Maintenance Agreement Required: ☐ Yes ☐ No

☑ House/Mod. Home No. Bedrooms 3

☐ Mobile Home No. Bathrooms 2

☐ Business No. Employees _____

☐ Other _____

☐ Slab ☑ Crawl Space ☐ Basement w/plumbing ☐ Basement wo/plumbing

Garbage Disposal: ☐ Yes ☑ No

Auto. Dishwasher: ☑ Yes ☐ No


Auto. Washing Machine: ☑ Yes ☐ No

Other _____

Comments _____

INITIAL SITE SKETCH

AS BUILT SKETCH

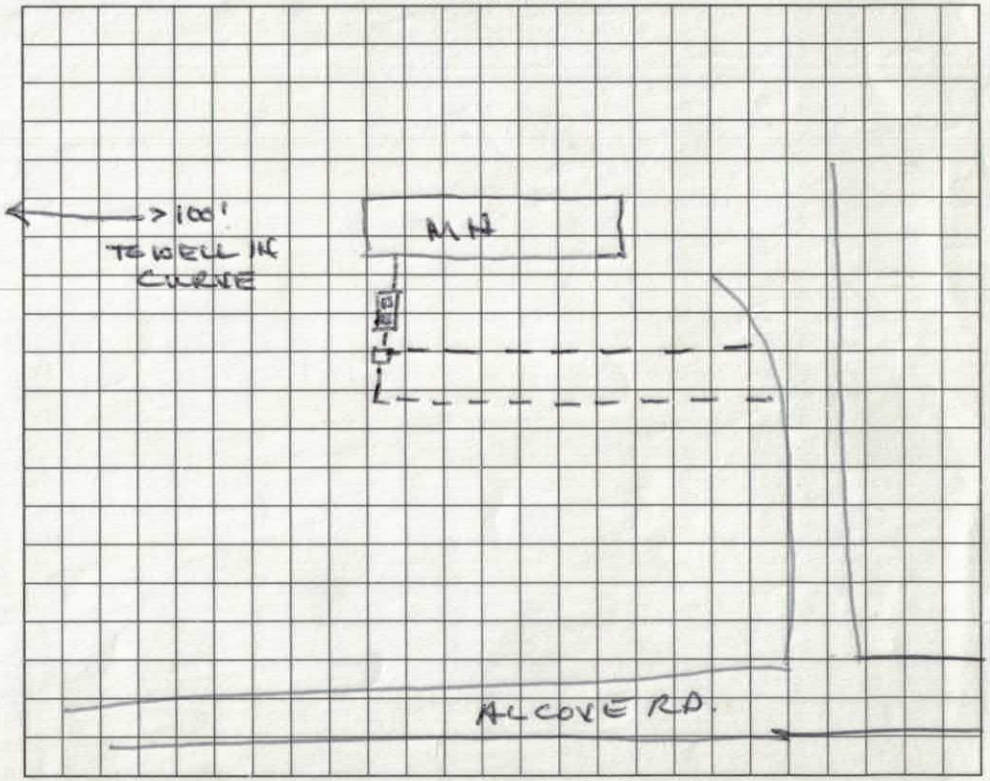

I understand that this permit can be suspended or revoked if any false information is supplied toward securing the permit/any unauthorized changes are made to the site/any unauthorized changes are made in the installation of the system. Improvement Permit is valid for 60 months from date of issuance.

Signed: _____

Improvement Permit by: _____ date _____

Existing System Inspection by: Wesley Sparkes date 8/20/93

Installed by: _____

Certificate of Completion by: _____ date _____

Operation Permit by: _____ date _____

HEALTH DEPT. COPY: WHITE INSPECTION COPY (FINAL): GREEN OWNER COPY (FINAL): YELLOW INSPECTION COPY (INITIAL): PINK OWNER COPY (INITIAL): GOLD