IREDELL COUNTY HEALTH DEPARTMENT

STATESVILLE 704-878-5305 MOORESVILLE 704-664-5281

IMPROVEMENT PERMIT / AUTHORIZATION TO CONSTRUCT / OPERATION PERMIT / EXISTING SYSTEM INSPECTION

PERMIT# 95138 PIN# 4646 64 7609 DATE 3/29/01

OWNER OR CONTRACTOR Eddie Clemmer PHONE: Business Home 704-455-4799

ADDRESS 119 Carawood Mooresville NC 28115

LOCATION Williamson, R Alcove, at end

SUBDIVISION Hager property BLOCK / SECTION LOT 5 LOT AREA 1.0AC SITE CLASS. P5 DESIGN FLOW 360 L.T.A.R. Existing

Septic Tank: Existing Gallons: STB Date

Pump Tank: Gallons: PT Date

Pump Make: Model Serial No.

Nitrification Field: No Fields Square Feet Linear Feet

No Lines Existing Trench Width Max Trench Bottom Depth Gravel Depth

☐ New System ☐ Repair System Type: (I) II. III. IV. V. VI

System Description: Existing - Conv.

Repair System Description:

Maintenance Agreement Required: ☐ Yes ☒ No

☐ House/Mod. Home ☒ Mobile Home ☐ Business ☐ Other

No. Bedrooms 3 No. Bathrooms 2 No. Employees

☐ Slab ☒ Crawl Space ☐ Basement w/plumbing ☐ Basement wo/plumbing

Water Supply: ☐ Individual ☒ Public ☒ Community


Comments:/Conditions:

Comments:/Conditions:

Mobile Home Must be 15' from each side Property Line

INITIAL SITE SKETCH

AS BUILT SKETCH

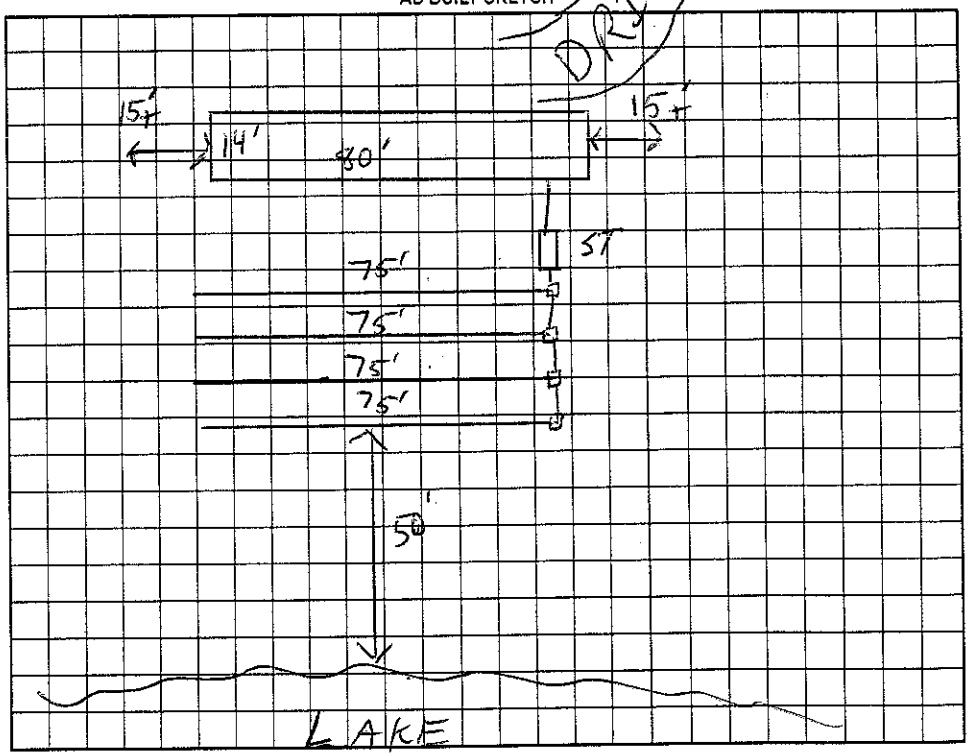

Permit can be suspended or revoked if any false information is supplied toward securing the permit/any unauthorized changes are made to the site/any unauthorized changes are made in the installation of the system. Improvement Permit with plat valid without expiration. Improvement Permit with site plan valid for sixty months. Authorization to Construct is valid for a period equal to that of Improvement Permit – not to exceed sixty months.

Signed: Eddie E Clemmer sr date 3-30-00

Improvement Permit by: date

Authorization to Construct by: date

Installed by:

Operation Permit by: date

Existing System Inspection by: RSI date 3/29/01

HEALTH DEPT. COPY: WHITE OWNER COPY (FINAL): YELLOW OWNER COPY (INITIAL): PINK