IREDELL COUNTY HEALTH DEPARTMENT

Statesville Phone TR 3-7271 Mooresville Phone No. 664-5

PERMIT TO INSTALL SEPTIC TANK

Permit No. 71 Permit Date 5-4- 1973

Owner Bryant Hager Address mooresville

Installed By Pete Hager Address Mooresville

Location of Property 1109 TL on 1206

Hager's Point Trailor Park


Lots 11 & 12

Tank		Capacity		Length of Lines		Fixtures	
Block	( )	1000	( )	225'	( )	No. of Baths	( )
Precast	(✓)	1250	(✓)	250'	( )	Dishwasher	( )
		1500	( )	Other 400'		Garbage Grdr.	( )
		Other				Other	

NOTIFY HEALTH DEPARTMENT AT LEAST EIGHT HOURS BEFORE TANK IS TO BE INSPECTED.

Final Inspection 5-4- 1973 Approved (✓) Disapprcved ( )

Remarks For Two Trailor only water System

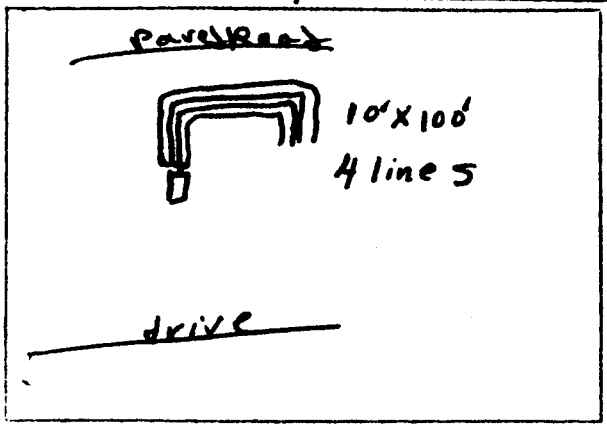

Sketch of Installation

J. C. Moore

Sanitarian