Site Address: 103 Hager Point Ln - Mtnsdl.

IREDELL COUNTY HEALTH DEPARTMENT

STATESVILLE 704-878-5305 MOORESVILLE 704-664-5281

IMPROVEMENT PERMIT / CERTIFICATE OF COMPLETION / OPERATION PERMIT / EXISTING SYSTEM INSPECTION

PROPERTY DESCRIPTION NO. Blanket PD DATE March 8, 95 TAX MAP NO. 4646-64-4609 8942.105 Watershed: ☐ Yes ☐ No

OWNER OR CONTRACTOR Bryant Hager PHONE: Business _____ Home _____

ADDRESS _____

LOCATION Alcove Road

SUBDIVISION Hagers Pt Mtn Park BLOCK / SECTION _____ LOT 1 LOT AREA _____ SITE CLASS. _____ DESIGN FLOW _____ L.T.A.R. _____

Septic Tank: Existing Gallons; STB _____ Date _____

Pump Tank: _____ Gallons; PT _____ Date _____

Pump Make: _____ Model _____ Serial No. _____

Nitrification Field: No Fields ___ Square Feet _____ Linear Feet _____

No Lines EXISTING Trench Width _____ Max Trench Bottom Depth _____ Gravel Depth _____

☐ New System ☐ Repair System Type: I, II, III, IV, V, VI

System Description: _____

Repair System Description: _____

Maintenance Agreement Required: ☐ Yes ☐ No

☐ House/Mod. Home ☑ Mobile Home ☐ Business ☐ Other _____

No. Bedrooms ___ No. Bathrooms ___ No. Employees ___

☐ Slab ☑ Crawl Space ☐ Basement w/plumbing ☐ Basement wo/plumbing


Water Supply: ☐ Individual ☐ Community ☐ Public

Comments:

Replacing MH in park
No signs of septic system malfunction

Comments:

INITIAL SITE SKETCH

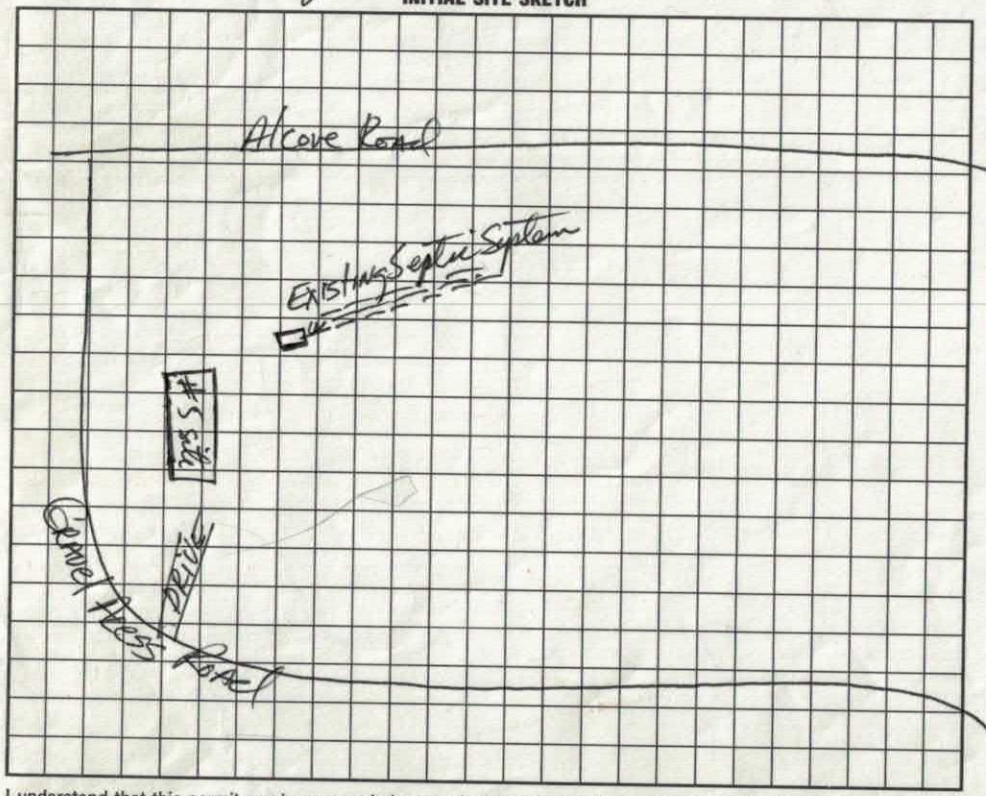

AS BUILT SKETCH

I understand that this permit can be suspended or revoked if any false information is supplied toward securing the permit/any unauthorized changes are made to the site/any unauthorized changes are made in the installation of the system. Improvement Permit is valid for 60 months from date of issuance.

Signed: _____

Improvement Permit by: _____ date _____

Existing System Inspection by: [signature] RS date 3/8/95

Installed by: _____

Certificate of Completion by: _____ date _____

Operation Permit by: _____ date _____

HEALTH DEPT. COPY: WHITE INSPECTION COPY (FINAL): GREEN OWNER COPY (FINAL): YELLOW INSPECTION COPY (INITIAL): PINK OWNER COPY (INITIAL): GOLD