IREDELL COUNTY HEALTH DEPARTMENT

STATESVILLE 704-878-5305 MOORESVILLE 704-664-5281

IMPROVEMENT PERMIT / CERTIFICATE OF COMPLETION / OPERATION PERMIT / EXISTING SYSTEM INSPECTION

PROPERTY DESCRIPTION NO. Blenkat P.O. DATE Sept. 24, 93 TAX MAP NO.

OWNER OR CONTRACTOR Bryant Hager PHONE: Business Home

Site ADDRESS 107 Hager Point Ln - Mrsal. 8942.107

LOCATION 21 S / X I-77 TR 1206 TR gravel rd. on left 4646-64-0992

SUBDIVISION Hagers Pt at H Pork BLOCK / SECTION LOT 2/6 LOT AREA Existing SITE CLASS. L.T.A.R.

Water Supply: ☐ Individual ☑ Community ☐ Public

Septic Tank: Existing Gallons; STB Date

Pump Tank: Gallons; PT Date

Nitrification Field: No Fields Existing Square Feet Linear Feet

No Lines Existing Trench Width Trench Depth Gravel Depth

☐ New System ☐ Repair System Type: I, II, II, IV, V, VI

System Description:

Repair System Description:

Maintenance Agreement Required: ☐ Yes ☐ No

☐ House/Mod. Home No. Bedrooms

☐ Mobile Home No. Bathrooms

☐ Business No. Employees

☐ Other

☐ Slab ☐ Crawl Space ☐ Basement w/plumbing ☐ Basement wo/plumbing

Garbage Disposal: ☐ Yes ☐ No

Auto. Dishwasher: ☐ Yes ☐ No


Auto. Washing Machine: ☐ Yes ☐ No

Other

Comments Replacing mobile home on #6. No sign of septic system malfunction.

INITIAL SITE SKETCH

AS BUILT SKETCH

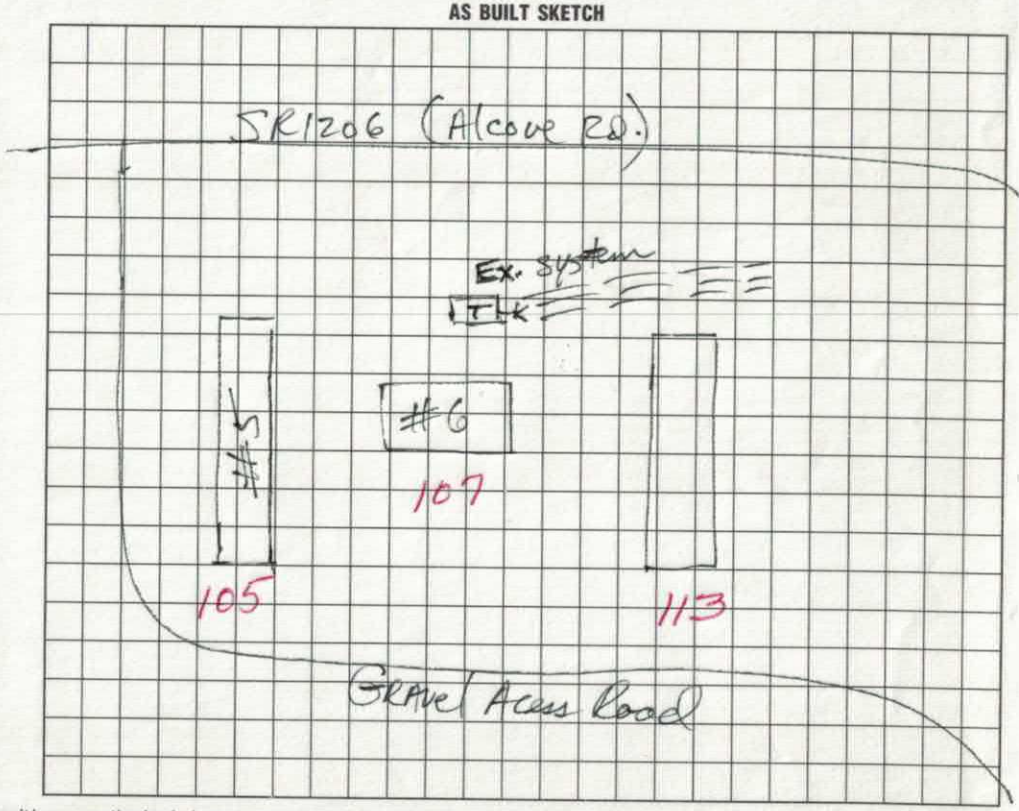

I understand that this permit can be suspended or revoked if any false information is supplied toward securing the permit/any unauthorized changes are made to the site/any unauthorized changes are made in the installation of the system. Improvement Permit is valid for 60 months from date of issuance.

Signed:

Improvement Permit by: date

Existing System Inspection by: date 9/24/93

Installed by:

Certificate of Completion by: date

Operation Permit by: date

HEALTH DEPT. COPY: WHITE INSPECTION COPY (FINAL): GREEN OWNER COPY (FINAL): YELLOW INSPECTION COPY (INITIAL): PINK OWNER COPY (INITIAL): GOLD