Site Address: 115 Hager Pond Ln - Mooresville

IREDELL COUNTY HEALTH DEPARTMENT

STATESVILLE 704-878-5305 MOORESVILLE 704-664-5281

IMPROVEMENT PERMIT / CERTIFICATE OF COMPLETION / OPERATION PERMIT / EXISTING SYSTEM INSPECTION

PROPERTY DESCRIPTION NO. Blanket DATE 5/28/97 TAX MAP NO. Blanket 4646-64-8942, 115 Watershed: ☐ Yes ☐ No

OWNER OR CONTRACTOR Hager MH Park PHONE: Business 663-2936 Home

ADDRESS 120 Bear Run Circle Mooresville, NC.

LOCATION Alcove Rd East, first mailboxes TL, ~ 4th space on (L)

SUBDIVISION Hager MH Park BLOCK / SECTION LOT 13 LOT AREA Existing SITE CLASS: DESIGN FLOW 360 L.T.A.R.

Septic Tank: Existing Gallons; GTB Date

Pump Tank: Gallons; PT Date

Pump Make: Model Serial No.

Nitrification Field: No Fields Square Feet Linear Feet

No Lines Trench Width Max Trench Bottom Depth Gravel Depth

☐ New System ☐ Repair System Type: I, II, III, IV, V, VI

System Description: Existing System.

Repair System Description:

Maintenance Agreement Required: ☐ Yes ☐ No

☐ House/Mod. Home ☒ Mobile Home ☐ Business ☐ Other

No. Bedrooms 3 No. Bathrooms 1 1/2 No. Employees

☐ Slab ☒ Crawl Space ☐ Basement w/plumbing ☐ Basement wo/plumbing


Water Supply: ☐ Individual ☒ Community ☐ Public

Comments:

Comments:

INITIAL SITE SKETCH

AS BUILT SKETCH

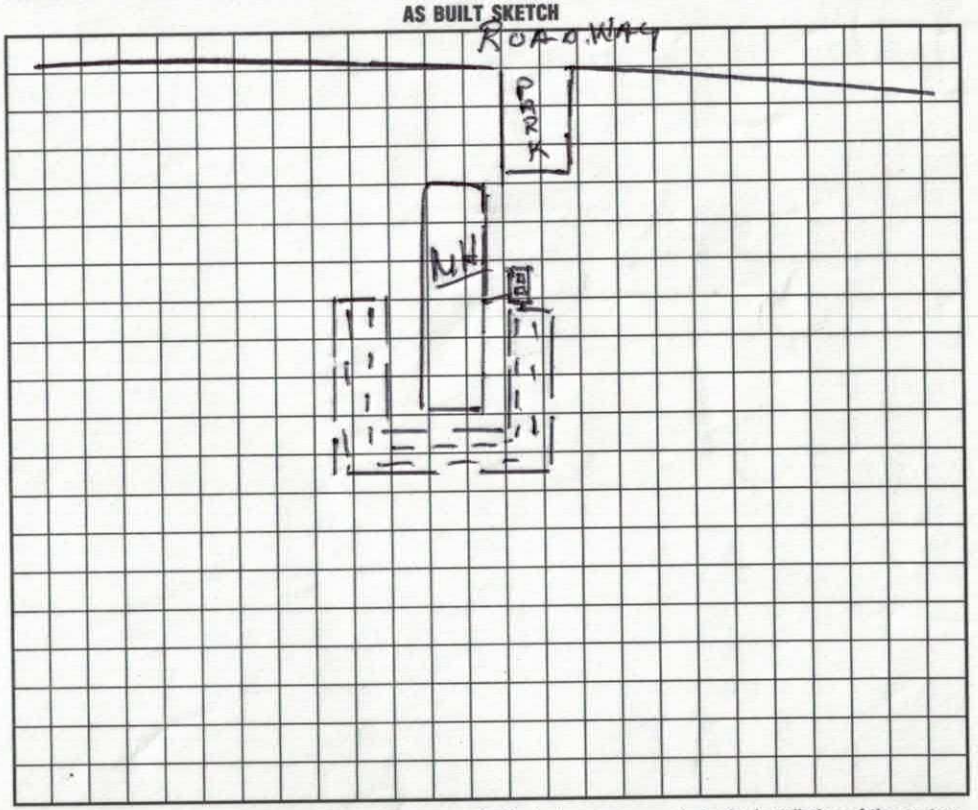

I understand that this permit can be suspended or revoked if any false information is supplied toward securing the permit/any unauthorized changes are made to the site/any unauthorized changes are made in the installation of the system. Improvement Permit is valid for 60 months from date of issuance.

Signed:

Improvement Permit by: date

Existing System Inspection by: date

Installed by:

Certificate of Completion by: Existing System; Wesley Sparks RS date 5/29/97

Operation Permit by: Wesley Sparks RS date 5/29/97

HEALTH DEPT. COPY: WHITE INSPECTION COPY (FINAL): GREEN OWNER COPY (FINAL): YELLOW INSPECTION COPY (INITIAL): PINK OWNER COPY (INITIAL): GOLD