Site Address: 113 Hedgefield Point Dr Mooresville

IREDELL COUNTY HEALTH DEPARTMENT

Existing System

STATESVILLE 704-878-5305 MOORESVILLE 704-664-5281

IMPROVEMENT PERMIT / ~~CERTIFICATE OF COMPLETION~~ / OPERATION PERMIT / EXISTING SYSTEM INSPECTION

PROPERTY DESCRIPTION NO. Existing System DATE 7/31/96 TAX MAP NO. N/A 4646-64-8942.117 Watershed: ☒ Yes ☐ No

OWNER OR CONTRACTOR Hagers Mobile Park PHONE: Business 663-2936 Home

ADDRESS 113 Hedgefield Pt Ln. Mooresville NC. 28115

LOCATION Hedgefield Pt Ln. off Alcove - 5th Lot on (R)

SUBDIVISION ~~Hedgefield Mtn~~ BLOCK / SECTION LOT ~~13~~ LOT AREA Existing SITE CLASS. DESIGN FLOW 360 L.T.A.R.

Septic Tank: Existing Gallons; STB Date

Pump Tank: Gallons; PT Date

Pump Make: Model Serial No.

Nitrification Field: No Fields Square Feet ~~Existing Septic Linear~~ Feet

No Lines Trench Width Max Trench Bottom Depth Gravel Depth

☐ New System ☐ Repair System Type: I (II) III. IV. V. VI

System Description: Existing System

Repair System Description:

Maintenance Agreement Required: ☐ Yes ☐ No

☒ House/Mod. Home No. Bedrooms 3

☐ Mobile Home No. Bathrooms 2

☐ Business No. Employees

☐ Other

☐ Slab ☐ Crawl Space ☐ Basement w/plumbing ☐ Basement wo/plumbing


Water Supply:
☐ Individual
☒ Community
☐ Public

Comments:

Comments:

INITIAL SITE SKETCH

AS BUILT SKETCH

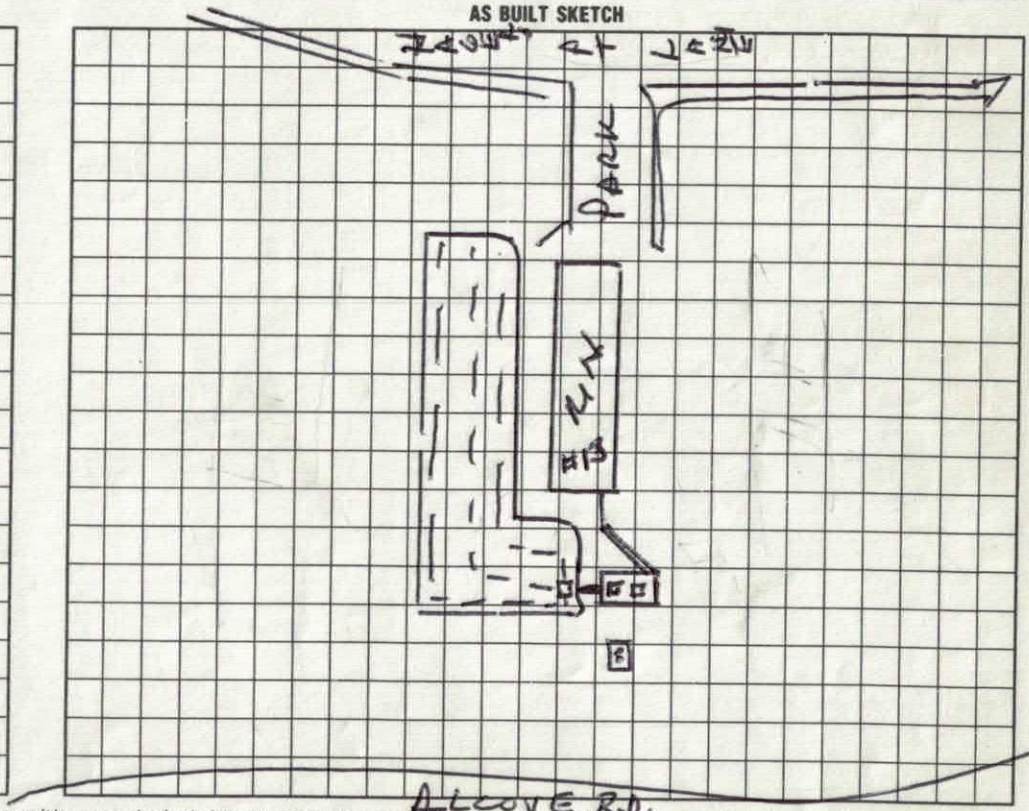

I understand that this permit can be suspended or revoked if any false information is supplied toward securing the permit/any unauthorized changes are made to the site/any unauthorized changes are made in the installation of the system.

Signed:

Improvement Permit by: date

Existing System Inspection by: date

Installed by: Existing System

~~Certificate of Completion~~ by: Wesley Sparks RS. date 7/31/96

Operation Permit by: date

HEALTH DEPT. COPY: WHITE INSPECTION COPY (FINAL): GREEN OWNER COPY (FINAL): YELLOW INSPECTION COPY (INITIAL): PINK OWNER COPY (INITIAL): GOLD