4646-64-8749

IREDELL COUNTY HEALTH DEPARTMENT

STATESVILLE 704-878-5305 MOORESVILLE 704-664-5281

IMPROVEMENT PERMIT / AUTHORIZATION TO CONSTRUCT / OPERATION PERMIT / EXISTING SYSTEM INSPECTI

PERMIT# 21703 PIN# 4646648942 M DATE 7/3/2002

OWNER OR CONTRACTOR Shirley Koehn PHONE: Business 336 969-2283 Home 336 972 6481

ADDRESS 455 College St Rural Hall, NC 27045

LOCATION Williamson Rd Exer I-77 TR Alcore TL Hagers Pt Rd.

SUBDIVISION Hagars Pt BLOCK / SECTION LOT 24 LOT AREA SITE CLASS. DESIGN FLOW 360gpd L.T.A.R.

Septic Tank: Existing Gallons; STB Date

Pump Tank: Existing Gallons; PT Date

Pump Make: Model Serial No.

Nitrification Field: No Fields Square Feet Linear Feet

No Lines Trench Width Existing Max Bench Bottom Depth Gravel Depth

☐ New System ☐ Repair System Type: I, II, III, IV, V, VI

System Description: Existing Gravity-Convent.

Repair System Description:

Maintenance Agreement Required: ☐ Yes ☒ No

☐ House/Mod. Home ☒ Mobile Home ☐ Business ☐ Other

No. Bedrooms 3 No. Bathrooms 2 No. Employees


☐ Slab ☒ Crawl Space ☐ Basement w/plumbing ☐ Basement wo/plumbing

Water Supply: ☒ Individual Share ☐ Public ☐ Community

Comments:/Conditions: Existing Septic System Appears to be Functioning Okay at time of inspection

Comments:/Conditions: Keep New MH at least 5' from Existing Septic System

INITIAL SITE SKETCH ★ Not to Scale

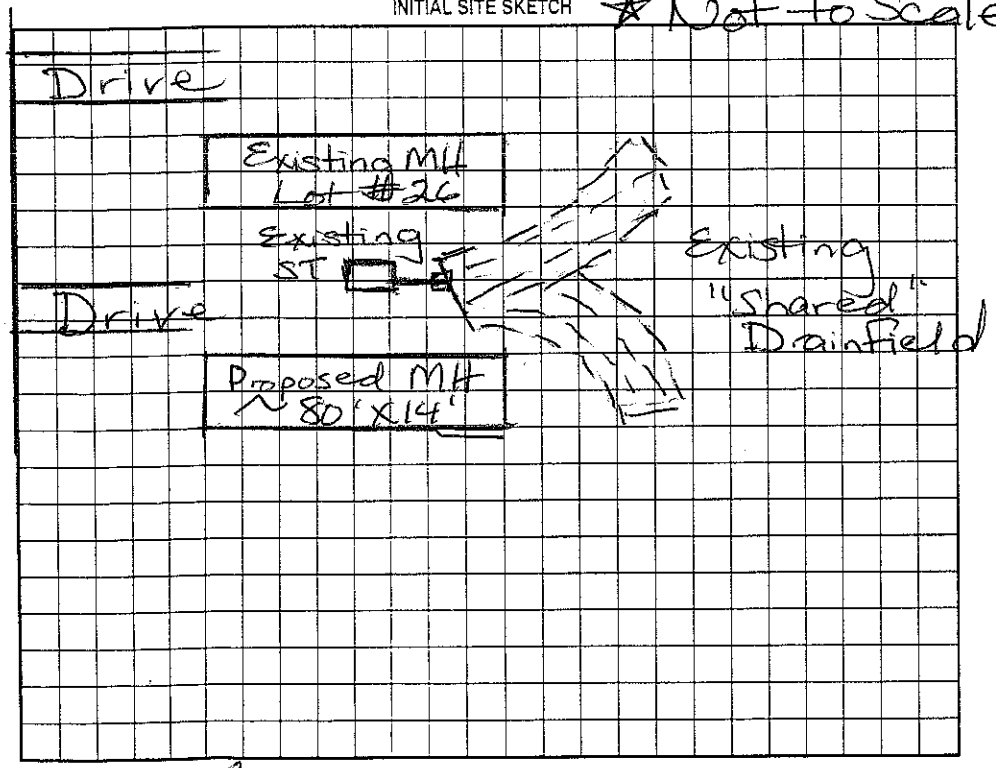

AS BUILT SKETCH

Permit can be suspended or revoked if any false information is supplied toward securing the permit/any unauthorized changes are made to the site/any unauthorized changes are made in the installation of the system. Improvement Permit with plat valid without expiration. Improvement Permit with site plan valid for sixty months. Authorization to Construct is valid for a period equal to that of Improvement Permit – not to exceed sixty months.

Signed: Shirley V. Koehn date

Improvement Permit by: Maria H. H. Dotson RS. date 7/3/2002

Authorization to Construct by: date

Installed by:

Operation Permit by: date

Existing System Inspection by: Maria H. H. Dotson RS. date 7/3/02

HEALTH DEPT. COPY: WHITE OWNER COPY (FINAL): YELLOW OWNER COPY (INITIAL): PINK