# IREDELL COUNTY HEALTH DEPARTMENT

STATESVILLE 704-878-5305 MOORESVILLE 704-664-5281

## IMPROVEMENT PERMIT / CERTIFICATE OF COMPLETION / OPERATION PERMIT / EXISTING SYSTEM INSPECTION

PROPERTY DESCRIPTION NO. _____ DATE June 8, '93 TAX MAP NO. _____

OWNER OR CONTRACTOR Bryant Hagen PHONE: Business _____ Home _____

ADDRESS Alcove Rd Mooresville

LOCATION 215 & I-77 TR 1206 near end TR gravel road on right

SUBDIVISION Hagen's Pt MH Park BLOCK / SECTION _____ LOT 24 & 26 LOT AREA 1 Ex. SITE CLASS. _____ L.T.A.R. _____

Water Supply: ☐ Individual ☑ Community ☐ Public

Septic Tank: Ex. Gallons; STB _____ Date _____

Pump Tank: _____ Gallons; PT _____ Date _____

Nitrification Field: No Fields 1 + 2 Ex. Square Feet 810 Linear Feet 270

No Lines _____ Trench Width 9' Trench Depth _____ Gravel Depth 24"

☐ New System ☑ Repair System Type: I, II, III, IV, V, VI

System Description: grav. bed

Repair System Description: grav. bed

Maintenance Agreement Required: ☐ Yes ☑ No

☐ House/Mod. Home No. Bedrooms 4-6 Garbage Disposal: ☐ Yes ☐ No

☑ Mobile Home 2 Ex. No. Bathrooms _____ Auto. Dishwasher: ☐ Yes ☐ No


☐ Business No. Employees _____ Auto. Washing Machine: ☐ Yes ☐ No

☐ Other _____ Other _____

☐ Slab ☐ Crawl Space ☐ Basement w/plumbing ☐ Basement wo/plumbing

Comments MH #26 has leaking plumbing which needs to be corrected.

**INITIAL SITE SKETCH**

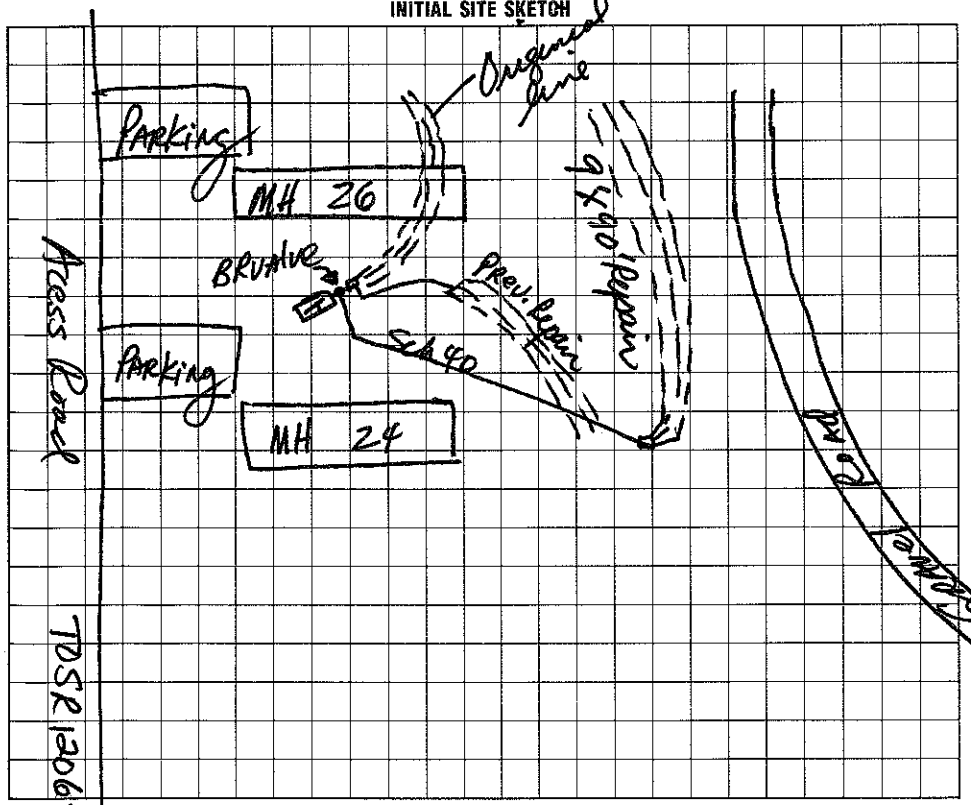


**AS BUILT SKETCH**

← As shown on initial site sketch

I understand that this permit can be suspended or revoked if any false information is supplied toward securing the permit/any unauthorized changes are made to the site/any unauthorized changes are made in the installation of the system. Improvement Permit is valid for 60 months from date of issuance.

Signed: _____

Improvement Permit by: D R Hamrick IRS. date 6/8/93

Existing System Inspection by: _____ date _____

Installed by: A Gervin

Certificate of Completion by: D R Hamrick IRS date 6/10/93

Operation Permit by: _____ date _____

HEALTH DEPT. COPY: WHITE INSPECTION COPY (FINAL): GREEN OWNER COPY (FINAL): YELLOW INSPECTION COPY (INITIAL): PINK OWNER COPY (INITIAL): GOLD