4646-74-0808

IREDELL COUNTY HEALTH DEPARTMENT

STATESVILLE 704-878-5305 MOORESVILLE 704-664-5281

IMPROVEMENT PERMIT / AUTHORIZATION TO CONSTRUCT / OPERATION PERMIT / EXISTING SYSTEM INSPECTION

PERMIT# 140464 PIN# 4646664894 2.123 DATE 2-9-07

OWNER OR APPLICANT Shirley Koehn PHONE: Business 336 413 3535 Home

ADDRESS 455 College St Rural Hall NC 27045

LOCATION Williamson Rd TR Bridgewater TL Hagers Pt Ln lot on left

SUBDIVISION Hagers Pt Mtt Park BLOCK / SECTION LOT 15 LOT AREA SITE CLASS. PS DESIGN FLOW L.T.A.R.

Septic Tank: Exist Gallons: STB Date

Pump Tank: Exist Gallons: STB Date

Pump Make: Model Serial No.

Nitrification Field: No Fields Square Feet Linear Feet

No Lines Trench Width Exist Max Trench Bottom Depth Gravel Depth ☐ Gravity ☐ Pressure

☐ New System ☐ Repair ☐ Expansion System Type: I II III IV V VI

System Description: Exist 29 Gray Convention

Repair System Description:

Maintenance Agreement Required: ☐ Yes ☐ No

☐ House/Mod. Home No. Bedrooms 2

☒ Mobile Home No. Persons

☐ Business No. Employees

☐ Other


Water Supply: ☒ Individual ☐ Public ☐ Community

☐ Slab ☐ Crawl Space ☐ Basement w/plumbing ☐ Basement wo/plumbing

Comments:/Conditions: Existing Septic System appears to be functioning okay at the time of the inspection

Comments:/Conditions:

INITIAL SITE SKETCH

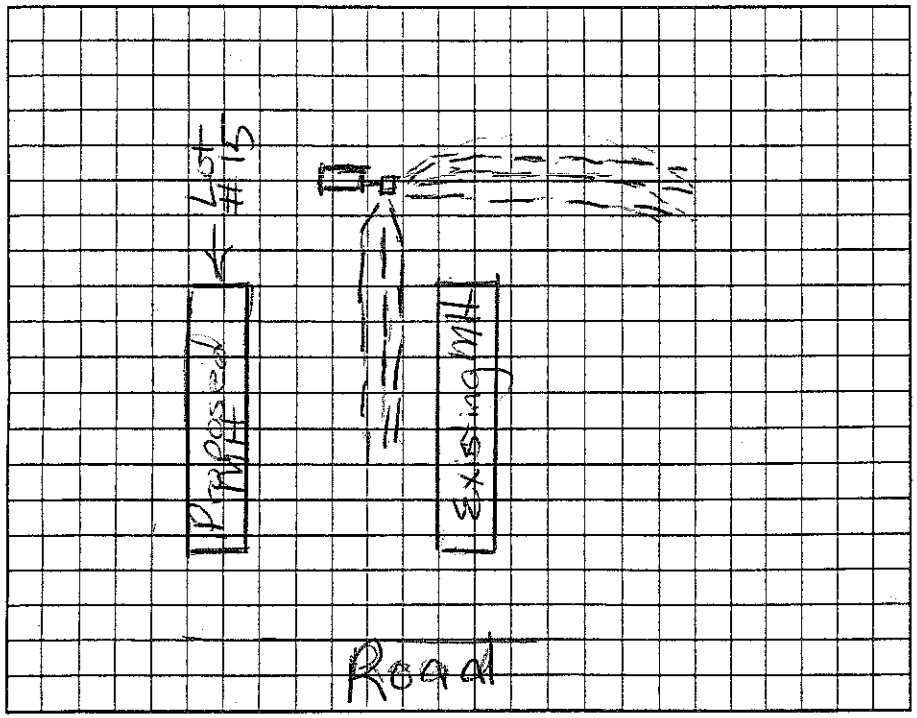

AS BUILT SKETCH

Permit can be suspended or revoked if any false information is supplied toward securing the permit/any unauthorized changes are made to the site/any unauthorized changes are made in the installation of the system. Improvement Permit with plat valid without expiration ☐ Improvement Permit with site plan valid for sixty months ☐ Authorization to Construct is valid for a period equal to that of Improvement Permit – not to exceed sixty months.

Signed: Shirley Koehn date

Improvement Permit by: Maria H Dotson RS date 2/9/07

Authorization to Construct by: Maria H Dotson RS date 2/9/07

Installed by:

Operation Permit by: date

Existing System Inspection by: Maria H Dotson RS date 2/9/07

HEALTH DEPT. COPY: WHITE OWNER COPY (FINAL): YELLOW OWNER COPY (INITIAL): PINK