4646-64-8791

IREDELL COUNTY HEALTH DEPARTMENT

STATESVILLE 704-878-5305 MOORESVILLE 704-664-5281

IMPROVEMENT PERMIT / AUTHORIZATION TO CONSTRUCT / OPERATION PERMIT / EXISTING SYSTEM INSPECTION

PERMIT# 140466 PIN# 4646648942 DATE 2-9-07

OWNER OR CONTRACTOR Shirley Koehn PHONE: Business 336-413-3535 Home

ADDRESS 455 College St. Rural Hall, NC 27045

LOCATION 128 Hager Pt Ln Williamson Rd TR Bridgewater TC into MH Park on Rt

SUBDIVISION Hagers Pt MH Park BLOCK / SECTION LOT 28 LOT AREA SITE CLASS. DESIGN FLOW L.T.A.R.

Septic Tank: Gallons: STB Date

Pump Tank: Existing Gallons: PT Date

Pump Make: Model Serial No.

Nitrification Field: No Fields Square Feet Linear Feet

No Lines Existing Trench Width Max Trench Bottom Depth Gravel Depth

☐ New System ☐ Repair System Type: I, II, III, IV, V, VI

System Description: Existing Grav. Convent

Repair System Description:

Maintenance Agreement Required: ☐ Yes ☒ No

☒ House/Mod. Home No. Bedrooms 2

☒ Mobile Home No. Bathrooms

☐ Business No. Employees

☐ Other

☐ Slab ☒ Crawl Space ☐ Basement w/plumbing ☐ Basement wo/plumbing


Water Supply:
☒ Individual
☐ Public
☐ Community

Comments:/Conditions: Existing Septic System appears to be functioning okay at time of inspection.

Comments:/Conditions: Keep new MH at least 5ft from Septic System

INITIAL SITE SKETCH

Not to Scale

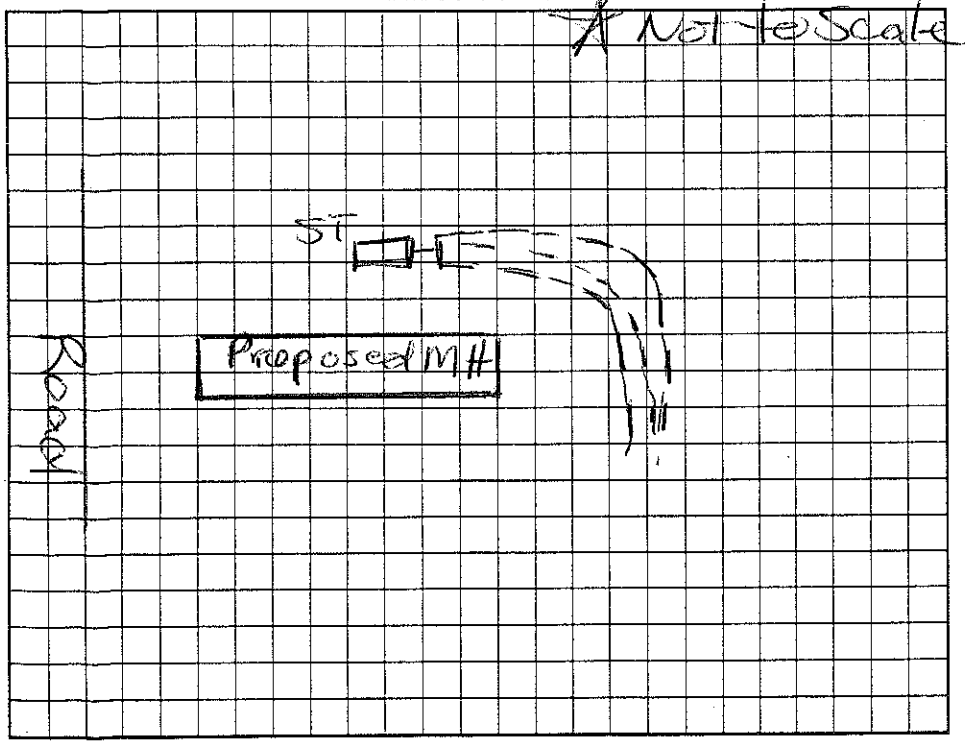

AS BUILT SKETCH

Permit can be suspended or revoked if any false information is supplied toward securing the permit/any unauthorized changes are made to the site/any unauthorized changes are made in the installation of the system. Improvement Permit with plat valid without expiration. Improvement Permit with site plan valid for sixty months. Authorization to Construct is valid for a period equal to that of Improvement Permit – not to exceed sixty months.

Signed: Shirley V. Koehn date

Improvement Permit by: Maura H. R. Dolan date 2/9/07

Authorization to Construct by: Maura H. R. Dolan date 2/9/07

Installed by:

Operation Permit by: date

Existing System Inspection by: Maura H. R. Dolan date 2/9/07

HEALTH DEPT. COPY: WHITE OWNER COPY (FINAL): YELLOW OWNER COPY (INITIAL): PINK