IREDELL COUNTY HEALTH DEPARTMENT

STATESVILLE 704-878-5305 MOORESVILLE 704-664-5281

IMPROVEMENT PERMIT / CERTIFICATE OF COMPLETION / OPERATION PERMIT / EXISTING SYSTEM INSPECTION

PROPERTY DESCRIPTION NO. Blanket P.D. DATE 8/15/95 TAX MAP NO. N/A Watershed: ☒ Yes ☐ No

OWNER OR CONTRACTOR Bryant Hagan - Hagans Pt. MH Park PHONE: Business _____ Home _____

ADDRESS 201 Court Rd No. Mooresville, NC.

LOCATION _____

SUBDIVISION Hagans Pt MH Park BLOCK / SECTION _____ LOT 28 LOT AREA _____ SITE CLASS. _____ DESIGN FLOW _____ L.T.A.R. _____

Septic Tank: _____ Gallons; STB _____ Date _____

Pump Tank: Existing Gallons; PT _____ Date _____

Pump Make: _____ Model _____ Serial No. _____

Nitrification Field: No Fields System Square Feet _____ Linear Feet _____

No Lines _____ Trench Width _____ Max Trench Bottom Depth _____ Gravel Depth _____

☐ New System ☐ Repair System Type: I, II, III, IV, V, VI

System Description: Existing System

Repair System Description: _____

Maintenance Agreement Required: ☐ Yes ☐ No

☐ House/Mod. Home No. Bedrooms _____

☐ Mobile Home No. Bathrooms _____

☐ Business No. Employees _____

☐ Other _____

☐ Slab ☐ Crawl Space ☐ Basement w/plumbing ☐ Basement wo/plumbing


Water Supply:
☐ Individual
☒ Community
☐ Public

Comments:

Comments:

INITIAL SITE SKETCH

AS BUILT SKETCH

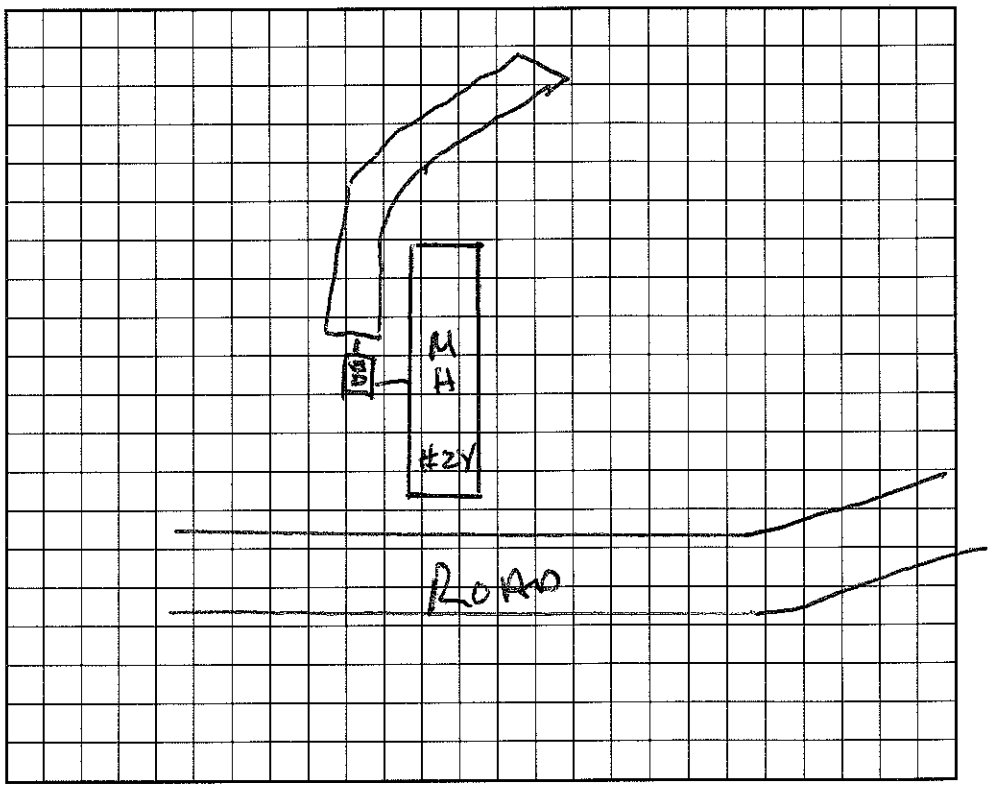

I understand that this permit can be suspended or revoked if any false information is supplied toward securing the permit/any unauthorized changes are made to the site/any unauthorized changes are made in the installation of the system. Improvement Permit is valid for 60 months from date of issuance.

Signed: _____ Installed by: _____

Improvement Permit by: _____ date _____ Certificate of Completion by: _____ date _____

Existing System Inspection by: Wesley Sparkes date 8/15/95 Operation Permit by: _____ date _____

HEALTH DEPT. COPY: WHITE INSPECTION COPY (FINAL): GREEN OWNER COPY (FINAL): YELLOW INSPECTION COPY (INITIAL): PINK OWNER COPY (INITIAL): GOLD