4646648942

IREDELL COUNTY HEALTH DEPARTMENT

STATESVILLE 704-878-5305 MOORESVILLE 704-664-5281

IMPROVEMENT PERMIT / AUTHORIZATION TO CONSTRUCT / OPERATION PERMIT / EXISTING SYSTEM INSPECTION

PERMIT# 146468 PIN# 4646648942.122 DATE 2-9-07

OWNER OR APPLICANT Shirley Keehn PHONE: Business 336 413 3535 Home

ADDRESS 455 College St Rural Hall, NC 27045

LOCATION 122 Hager Rd Ln Williamson Rd TR Bridgewater TL Hager Rd Ln on ~~left~~ right

SUBDIVISION BLOCK / SECTION LOT 24 LOT AREA SITE CLASS. DESIGN FLOW L.T.A.R.

Septic Tank: Existing Gallons: STB Date

Pump Tank: Existing Gallons: PT Date

Pump Make: Model Serial No.

Nitrification Field: No Fields Square Feet Existing Linear Feet

No Lines Trench Width Max Trench Bottom Depth Gravel Depth ☐ Gravity ☐ Pressure

☐ New System ☐ Repair ☐ Expansion System Type: I II III IV V VI

System Description: Existing Grav. Conventional

Repair System Description:

Maintenance Agreement Required: ☐ Yes ☐ No

☐ House/Mod. Home No. Bedrooms 3

☒ Mobile Home No. Persons

☐ Business No. Employees

☐ Other


Water Supply: ☒ Individual Shared ☐ Public ☐ Community

☐ Slab ☐ Crawl Space ☐ Basement w/plumbing ☐ Basement wo/plumbing

Comments/Conditions: Existing Septic System appears to be functioning okay at time of inspection.

Comments/Conditions: Keep new MH at least 5ft from Septic System.

INITIAL SITE SKETCH Not to Scale

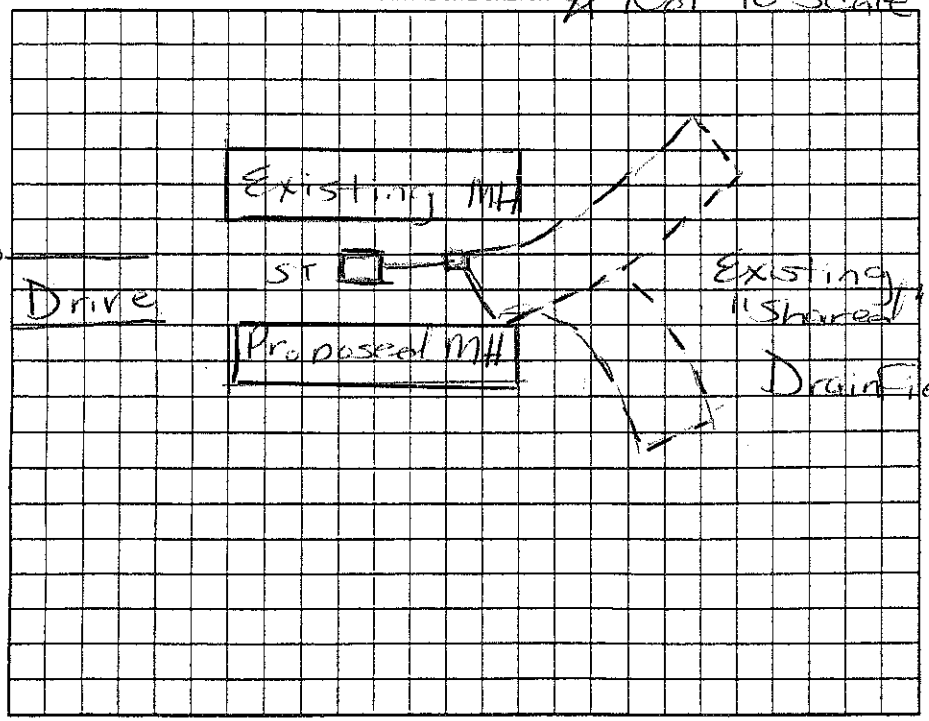

AS BUILT SKETCH

Permit can be suspended or revoked if any false information is supplied toward securing the permit/any unauthorized changes are made to the site/any unauthorized changes are made in the installation of the system. Improvement Permit with plat valid without expiration ☐ Improvement Permit with site plan valid for sixty months ☐ Authorization to Construct is valid for a period equal to that of Improvement Permit – not to exceed sixty months.

Signed: date

Improvement Permit by: RS date 2/9/07

Authorization to Construct by: RS date 2/9/07

Installed by:

Operation Permit by: date

Existing System Inspection by: RS date 2/9/07

HEALTH DEPT. COPY: WHITE OWNER COPY (FINAL): YELLOW OWNER COPY (INITIAL): PINK