1.30

IREDELL COUNTY HEALTH DEPARTMENT

STATESVILLE 704-878-5305 MOORESVILLE 704-664-5281

IMPROVEMENT PERMIT / CERTIFICATE OF COMPLETION / OPERATION PERMIT / EXISTING SYSTEM INSPECTION

PROPERTY DESCRIPTION NO. Blanket Hager's Pointe MH Pk DATE 12/1/97 TAX MAP NO. See below Watershed: ☒ Yes ☐ No

OWNER OR CONTRACTOR Hager's Pointe MH Pk PHONE: Business _____ Home 663-2936

ADDRESS Mooresville, NC 28115

LOCATION From I-77 TR Alcove Park on left

SUBDIVISION Hager's Pt. MH BLOCK / SECTION _____ LOT 30&31 LOT AREA Existing SITE CLASS. _____ DESIGN FLOW _____ L.T.A.R. _____

Septic Tank: Existing Gallons; STB _____ Date _____

Pump Tank: _____ Gallons; PT _____ Date _____

Pump Make: _____ Model _____ Serial No. _____

Nitrification Field: No Fields ___ Square Feet _____ Linear Feet _____

No Lines Existing Trench Width _____ Max Trench Bottom Depth _____ Gravel Depth _____

☐ New System ☐ Repair System Type: I, II, III, IV, V, VI

System Description: _____

Repair System Description: Existing

Maintenance Agreement Required: ☐ Yes ☐ No

☐ House/Mod. Home No. Bedrooms ___

☒ Mobile Home No. Bathrooms ___

☐ Business No. Employees ___

☐ Other _____


☐ Slab ☐ Crawl Space ☐ Basement w/plumbing ☐ Basement wo/plumbing

Water Supply:
☐ Individual
☒ Community
☐ Public


Comments: Septic System appears to be functioning okay at time of inspection. No problems detected.

Comments:

INITIAL SITE SKETCH Not to Scale

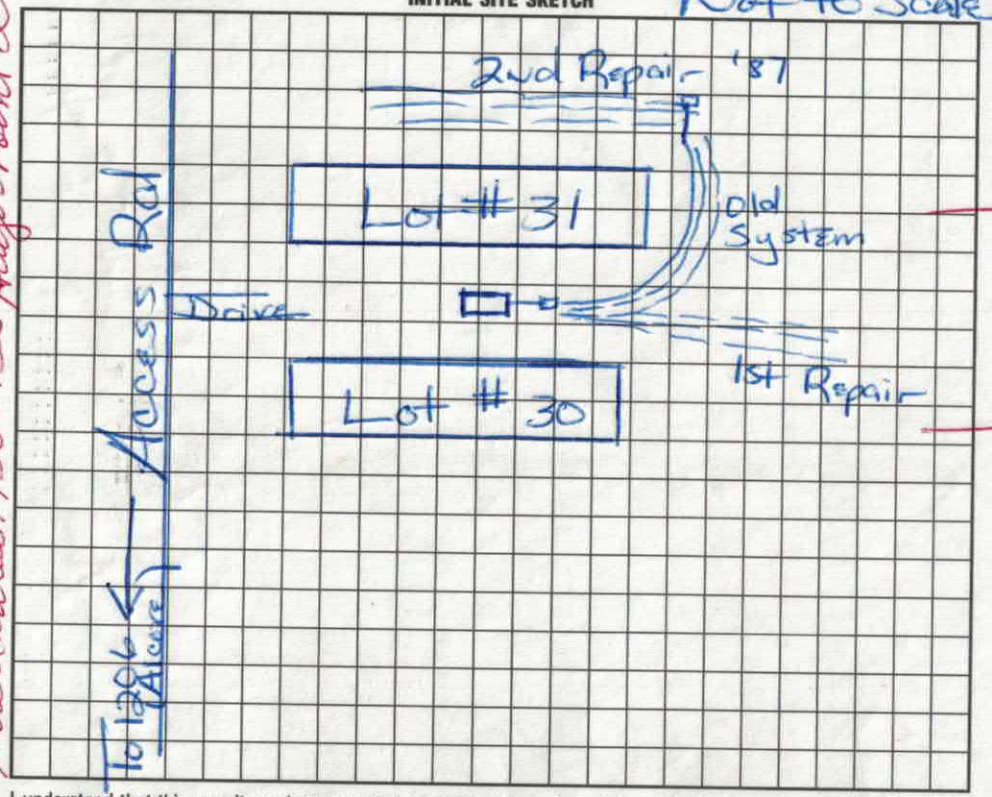

AS BUILT SKETCH

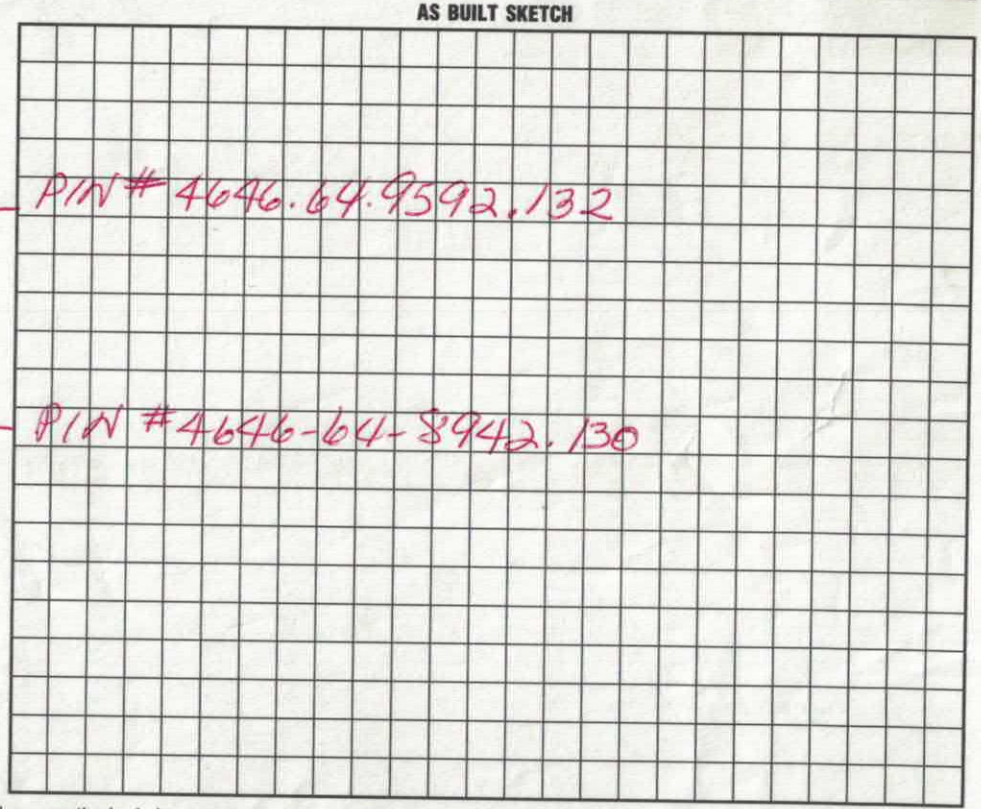

I understand that this permit can be suspended or revoked if any false information is supplied toward securing the permit/any unauthorized changes are made to the site/any unauthorized changes are made in the installation of the system. Improvement Permit is valid for 60 months from date of issuance.

Signed: Jo Hager

Improvement Permit by: Maria H. Dotson date 12/1/97

Existing System Inspection by: Maria H. Dotson date 12/1/97

Installed by: _____

Certificate of Completion by: _____ date _____

Operation Permit by: _____ date _____

HEALTH DEPT. COPY: WHITE INSPECTION COPY (FINAL): GREEN OWNER COPY (FINAL): YELLOW INSPECTION COPY (INITIAL): PINK OWNER COPY (INITIAL): GOLD

Site Address: 130 & 132 Hager Point Ln - Mtrl.