IREDELL COUNTY HEALTH DEPARTMENT

STATESVILLE 704-878-5305 MOORESVILLE 704-664-5281

IMPROVEMENT PERMIT / CERTIFICATE OF COMPLETION / OPERATION PERMIT / EXISTING SYSTEM INSPECTION

PROPERTY DESCRIPTION NO. Blanket DATE 12/1/97 TAX MAP NO. Blanket 4646-64-8942.133 tershed: ☒ Yes ☐ No

OWNER OR CONTRACTOR Hager's Point Mobile Home Pk PHONE: Business Home 9592.137

ADDRESS 113 Hager's Pt Ln Mooresville, NC / Rt 2 Box 398-4

LOCATION Williamson Rd from I-77 TR Alcove Park on left

SUBDIVISION Hager's Pt mH BLOCK / SECTION LOT 19 & 21 LOT AREA Existing SITE CLASS. DESIGN FLOW Existing L.T.A.R.

Septic Tank: Existing Gallons; STB Date

Pump Tank: Gallons; PT Date

Pump Make: Model Serial No.

Nitrification Field: No Fields Square Feet Linear Feet

No Lines Existing Trench Width Max Trench Bottom Depth Gravel Depth

☐ New System ☐ Repair System Type: I, II, III, IV, V, VI

System Description:

Repair System Description: Existing

Maintenance Agreement Required: ☐ Yes ☐ No

☐ House/Mod. Home No. Bedrooms

☒ Mobile Home No. Bathrooms

☐ Business No. Employees

☐ Other


☐ Slab ☐ Crawl Space ☐ Basement w/plumbing ☐ Basement wo/plumbing

Water Supply:
☐ Individual
☒ Community
☐ Public


Comments: Existing Septic System appears to be functing Okay at time of inspection.

Comments:

INITIAL SITE SKETCH NOT TO SCALE

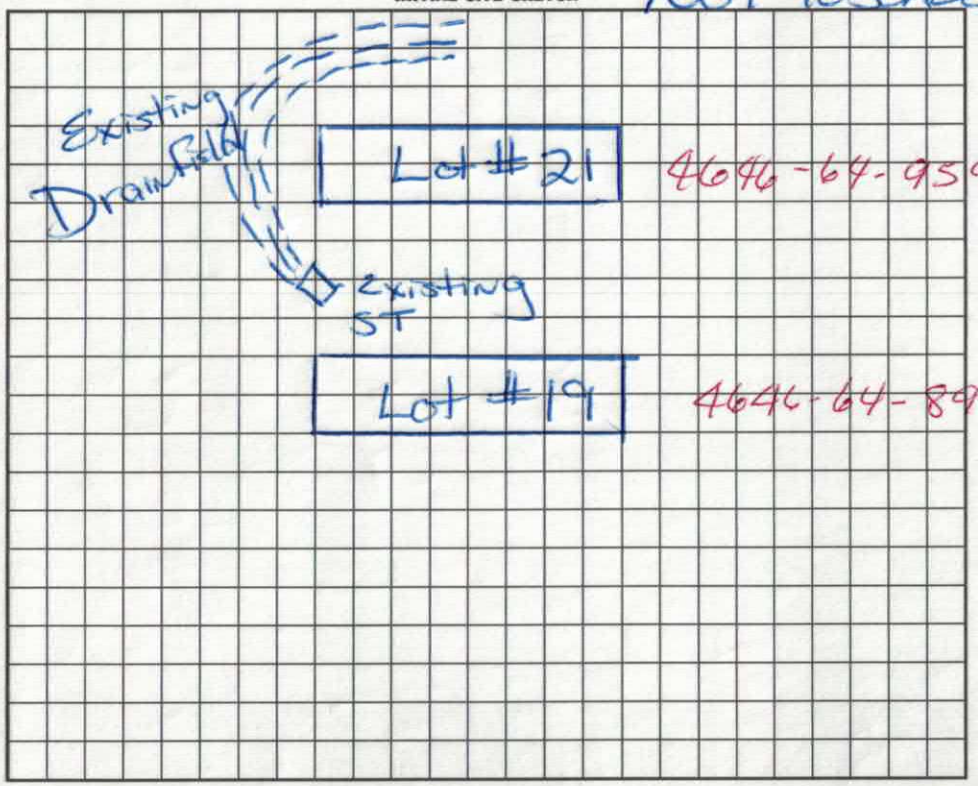

AS BUILT SKETCH

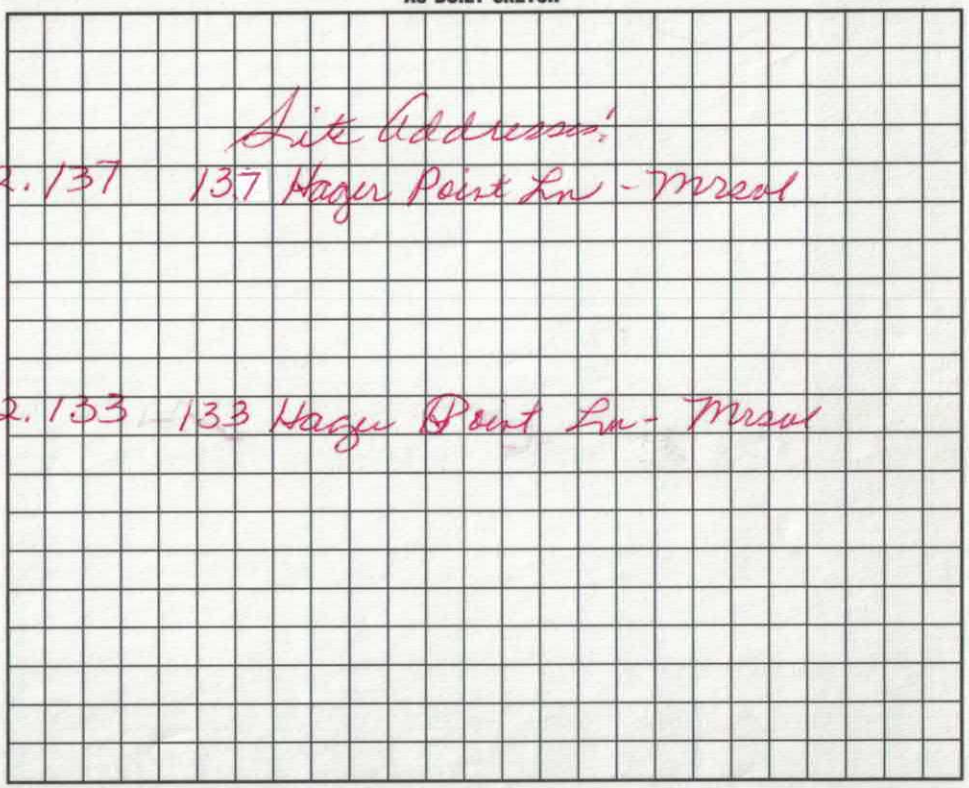

I understand that this permit can be suspended or revoked if any false information is supplied toward securing the permit/any unauthorized changes are made to the site/any unauthorized changes are made in the installation of the system. Improvement Permit is valid for 60 months from date of issuance.

Signed: Jo Hager

Improvement Permit by: Maria H. H. Watson date 12/1/97

Existing System Inspection by: Maria H. H. Watson date 12/1/97

Installed by:

Certificate of Completion by: date

Operation Permit by: date

HEALTH DEPT. COPY: WHITE INSPECTION COPY (FINAL): GREEN OWNER COPY (FINAL): YELLOW INSPECTION COPY (INITIAL): PINK OWNER COPY (INITIAL): GOLD