4646-74-0457

IREDELL COUNTY HEALTH DEPARTMENT

STATESVILLE 704-878-5305 MOORESVILLE 704-664-5281

IMPROVEMENT PERMIT / AUTHORIZATION TO CONSTRUCT / OPERATION PERMIT / EXISTING SYSTEM INSPECTION

PERMIT# 6626 PIN# 4646648942 DATE 5/28/99

OWNER OR CONTRACTOR Bryant Hager PHONE: Business Home 663-2936

ADDRESS 120 Bear Run Circle Mooresville NC

LOCATION Alcove IL Hagers Pt Rd last lot on left

SUBDIVISION Hagers Point BLOCK / SECTION J LOT 27 LOT AREA SITE CLASS. DESIGN FLOW EXISTING

Septic Tank: Exist Gallons: STB Date

Pump Tank: Exist Gallons: PT Date

Pump Make: Model Serial No.

Nitrification Field: No Fields Square Feet Linear Feet

No Lines Exist Trench Width 9 Max Trench Bottom Depth Gravel Depth

☐ New System ☐ Repair System Type: I (II) III, IV, V, VI

System Description: EXISTING

Repair System Description:

Maintenance Agreement Required: ☐ Yes ☐ No

☐ House/Mod. Home No. Bedrooms 3

☒ Mobile Home No. Bathrooms 2

☐ Business No. Employees

☐ Other

☐ Slab ☐ Crawl Space ☐ Basement w/plumbing ☐ Basement wo/plumbing


Water Supply: ☐ Individual ☒ Public ☒ Community

Comments:/Conditions: Septic System appears to be functioning okay. No problems noticed at time of inspection

Comments:/Conditions: Repair installed 1979

Not to Scale

INITIAL SITE SKETCH

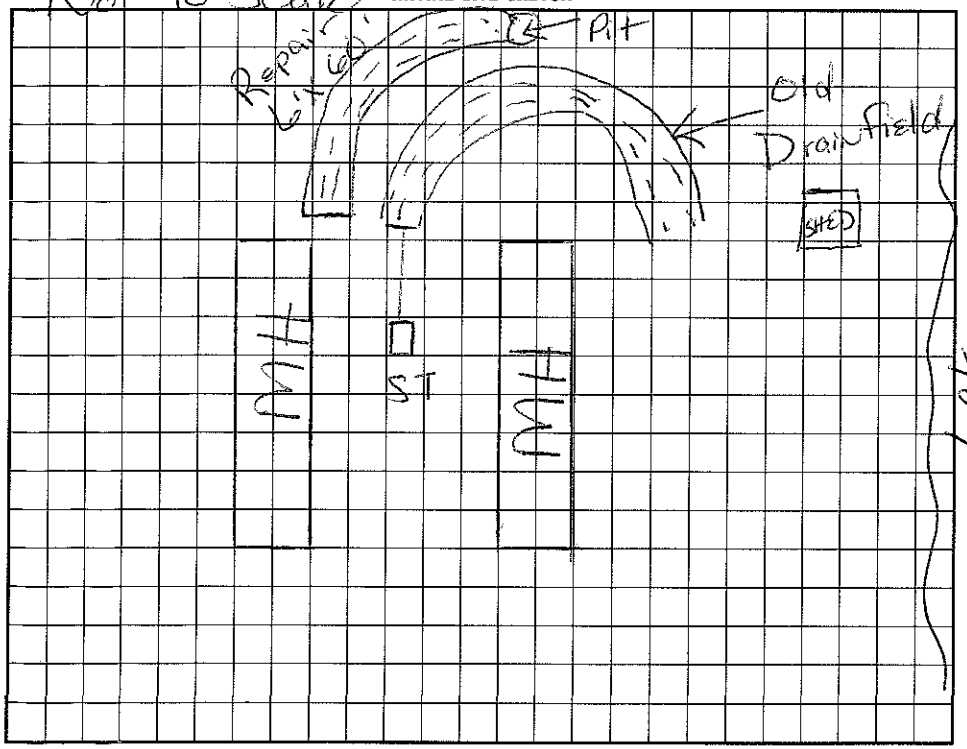

AS BUILT SKETCH

I understand that this permit can be suspended or revoked if any false information is supplied toward securing the permit/any unauthorized changes are made to the site/any unauthorized changes are made in the installation of the system. Improvement Permit with plat valid without expiration. Improvement Permit with site plan valid for sixty months. Authorization to Construct is valid for a period equal to that of Improvement Permit – not to exceed sixty months.

Signed: [signature] date

Improvement Permit by: Maria H Dotson RS date 5/28/99

Authorization to Construct by: date

Installed by:

Operation Permit by: date

Existing System Inspection by: Maria Dotson date 5/28/99

HEALTH DEPT. COPY: WHITE INSPECTION COPY (FINAL): GREEN OWNER COPY (FINAL): YELLOW INSPECTION COPY (INITIAL): PINK OWNER COPY (INITIAL): GOLD

* Pd 5/28/99 #100.00 For Lots 27 & 13