IREDELL COUNTY HEALTH DEPARTMENT

STATESVILLE 704-878-5305 MOORESVILLE 704-664-5281

IMPROVEMENT PERMIT / ~~CERTIFICATE OF COMPLETION~~ / OPERATION PERMIT / EXISTING SYSTEM INSPECTION

AMD ___ 4YEAR ___ CONSTRUCT FM# 4646-65-0353 662-8795

PROPERTY DESCRIPTION NO. 25845 DATE 12/9/97 TAX MAP NO. 4646654314 pt of Watershed: ☑ Yes ☐ No

OWNER OR CONTRACTOR JEFF YELTON PHONE: Business 332-2446 Home

ADDRESS 119 E. 7TH ST. CHARLOTTE NC 28210

LOCATION 215 TR ALCOVE (AWAY FROM LANDTREE) AT END ON RT

SUBDIVISION BRIDGEWATER BLOCK / SECTION ___ LOT 1 LOT AREA ___ SITE CLASS RS DESIGN FLOW 450 GPD L.T.A.R. .25 GPD/FT²

Septic Tank: 1000 Gallons; STB 312 Date 10/16/00

Pump Tank: ___ Gallons; PT ___ Date ___

Pump Make: ___ Model ___ Serial No. ___

Nitrification Field: No Fields 1 Square Feet 640 Linear Feet 320

No Lines 5@64' Trench Width 24" Max Trench Bottom Depth 36" Gravel Depth N/A

☑ New System ☐ Repair System Type: I, II, (III), IV, V, VI

System Description: GRAVITY PANEL

Repair System Description: PUMP PANEL

Maintenance Agreement Required: ☐ Yes ☑ No

☑ House/Mod. Home No. Bedrooms 4

☐ Mobile Home No. Bathrooms 4

☐ Business No. Employees ___

☐ Other ___


☐ Slab ☑ Crawl Space ☐ Basement w/plumbing ☐ Basement wo/plumbing

Water Supply: ☑ Individual ☐ Community ☐ Public

Comments:

Comments:

INITIAL SITE SKETCH 1"=60'

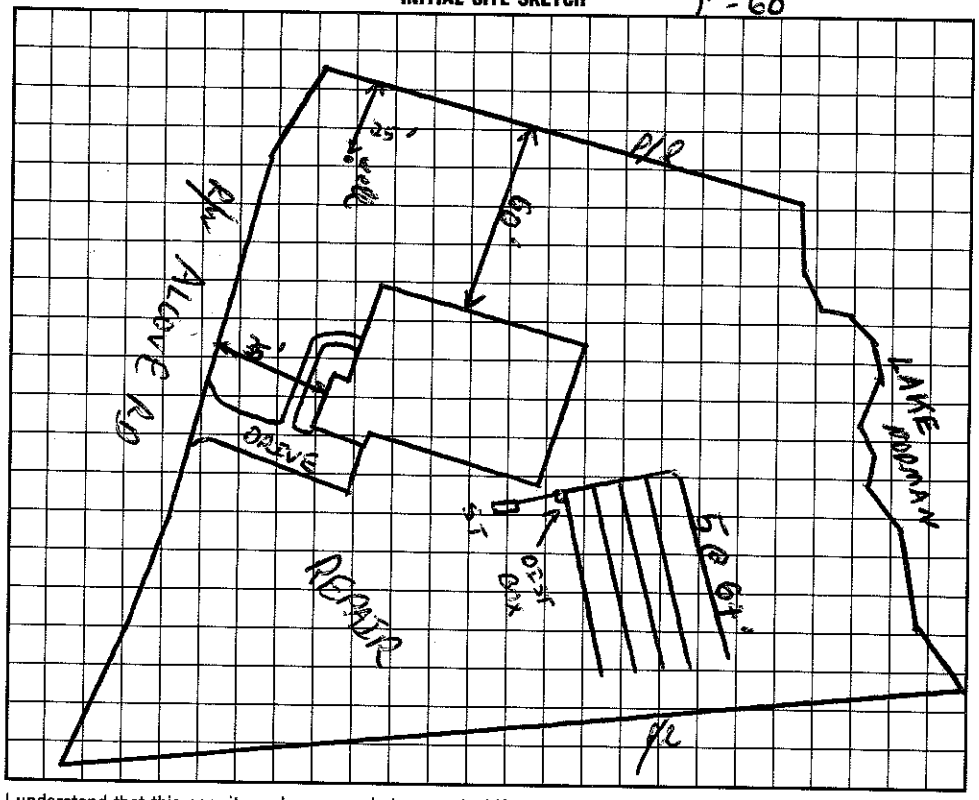

AS BUILT SKETCH

Installed as PS

Drawn

I understand that this permit can be suspended or revoked if any false information is supplied toward securing the permit/any unauthorized changes are made to the site/any unauthorized changes are made in the installation of the system. Improvement Permit is valid for 60 months from date of issuance.

Signed: ___

Improvement Permit by: RS date 12/9/97

AUTHORIZATION TO CONSTRUCT Existing System Inspection by: RS date 12/9/97

Installed by: Orbison

Certificate of Completion by: ___ date ___

Operation Permit by: RS date 1/26/01

HEALTH DEPT. COPY: WHITE INSPECTION COPY (FINAL): GREEN OWNER COPY (FINAL): YELLOW INSPECTION COPY (INITIAL): PINK OWNER COPY (INITIAL): GOLD