IREDELL COUNTY HEALTH DEPARTMENT

STATESVILLE 704-878-5305 50.00 Paid MOORESVILLE 704-664-5281

IMPROVEMENT PERMIT / AUTHORIZATION TO CONSTRUCT / OPERATION PERMIT / EXISTING SYSTEM INSPECTION

PERMIT# 129785 PIN# 4646 65 4365.000 DATE 7/7/05

OWNER OR CONTRACTOR David Walser PHONE: Business Home 704-892-8440

ADDRESS 730 Cleary Rd. Mooresville, NC. 28117

LOCATION 730 Alcove Rd., Williamson N TR Alcove Rd. on Rt. before sharp Curve

SUBDIVISION Bridgewater Landing BLOCK / SECTION LOT 4 LOT AREA .71AC SITE CLASS PS DESIGN FLOW 480 L.T.A.R. .3

Septic Tank: 1000 Gallons; STB 794 Date 5/9/06
Pump Tank: 1000 Gallons; PT 293 Date 5/12/06
Pump Make: Goulds Model WE0 312HP4 Serial No.
Nitrification Field: No Fields 1 Square Feet 540 Linear Feet 270
No Lines 6@45' Trench Width 2-3' Max Trench Bottom Depth 3' Gravel Depth N/A

[X] New System [ ] Repair System Type: I, II, III, [IV], V, VI
System Description: PressDemand - PPBPS
Repair System Description: Same
Maintenance Agreement Required: [X] Yes [ ] No
[ ] Slab [ ] Crawl Space [X] Basement w/plumbing [ ] Basement wo/plumbing

[X] House/Mod. Home No. Bedrooms 4
[ ] Mobile Home No. Bathrooms 4
[ ] Business No. Employees
[ ] Other 1½


Water Supply: [X] Individual [ ] Public [ ] Community

Comments:/Conditions: Well must be 100' from any part of Septic Tank System. In line filter installed


Comments:/Conditions: Tanks & lines Checked 6/16/06 GM 60 Panels 3/16" holes

(1" = 60')

INITIAL SITE SKETCH

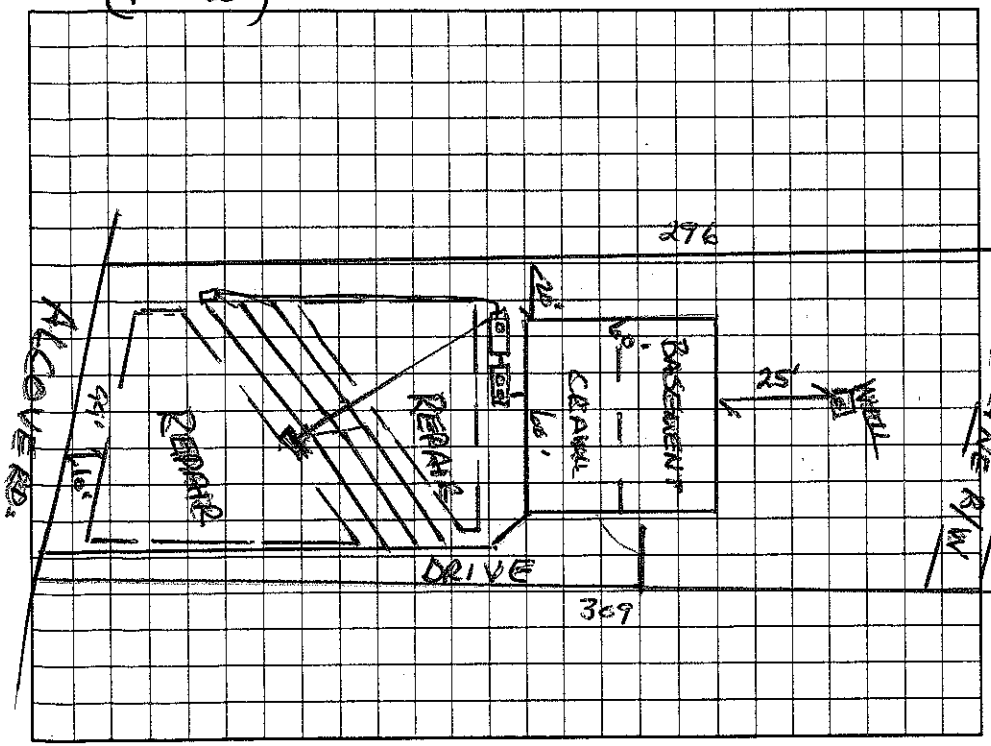

AS BUILT SKETCH

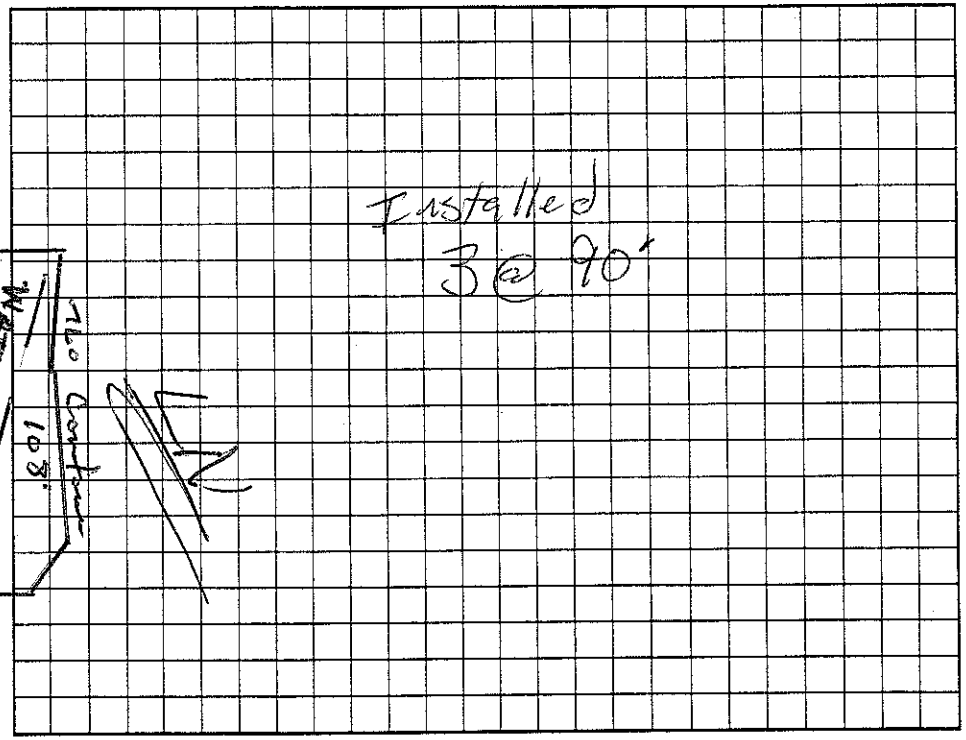

Permit can be suspended or revoked if any false information is supplied toward securing the permit/any unauthorized changes are made to the site/any unauthorized changes are made in the installation of the system. Improvement Permit with plat valid without expiration. Improvement Permit with site plan valid for sixty months. Authorization to Construct is valid for a period equal to that of Improvement Permit – not to exceed sixty months.

Signed: x David Walser date 7/25/05
Improvement Permit by: Wesley Sparks RS. date 7/7/05
Authorization to Construct by: Wesley Sparks RS date 7/7/05

Installed by: R+H RS
Operation Permit by: Maria Dobson date 7/27/06
Existing System Inspection by: date

HEALTH DEPT. COPY: WHITE OWNER COPY (FINAL): YELLOW OWNER COPY (INITIAL): PINK