737-6633

IREDELL COUNTY HEALTH DEPARTMENT

STATESVILLE 704-878-5305 MOORESVILLE 704-664-5281

IMPROVEMENT PERMIT / AUTHORIZATION TO CONSTRUCT / OPERATION PERMIT / EXISTING SYSTEM INSPECTION

PERMIT# 12128 PIN# 4644750226130 DATE 6-5-04

OWNER OR CONTRACTOR Pat Davidson PHONE: Business 737-6633 Home 663-0220

ADDRESS 714 Alcove Rd Mooresville, NC 28117

LOCATION

SUBDIVISION DAVIDSON BK / SECTION LOT 1 LOT AREA SITE CLASS. PS DESIGN FLOW 360gpd L.T.A.R.

Septic Tank: Exist Gallons; STB Date

Pump Tank: Gallons; PT Date

Pump Make: Model Serial No.

Nitrification Field: No Fields Square Feet Existing Linear Feet

No Lines Trench Width Max Trench Bottom Depth Gravel Depth

☐ New System ☐ Repair System Type: I, II, III, IV, V, VI

System Description: Existing Gravity Convent

Repair System Description:

Maintenance Agreement Required: ☐ Yes ☒ No

☐ House/Mod. Home No. Bedrooms 3

☒ Mobile Home No. Bathrooms 2

☐ Business No. Employees

☐ Other


☐ Slab ☒ Crawl Space ☐ Basement w/plumbing ☐ Basement wo/plumbing

Water Supply:
☐ Individual
☒ Public
☒ Community

Comments:/Conditions: Existing Septic System appears to be functioning okay at the time of inspection, no problems noticeable

Comments:/Conditions: Reinspected 2/16/05; System still appears to be functioning okay. MS

INITIAL SITE SKETCH ☆ Not to Scale

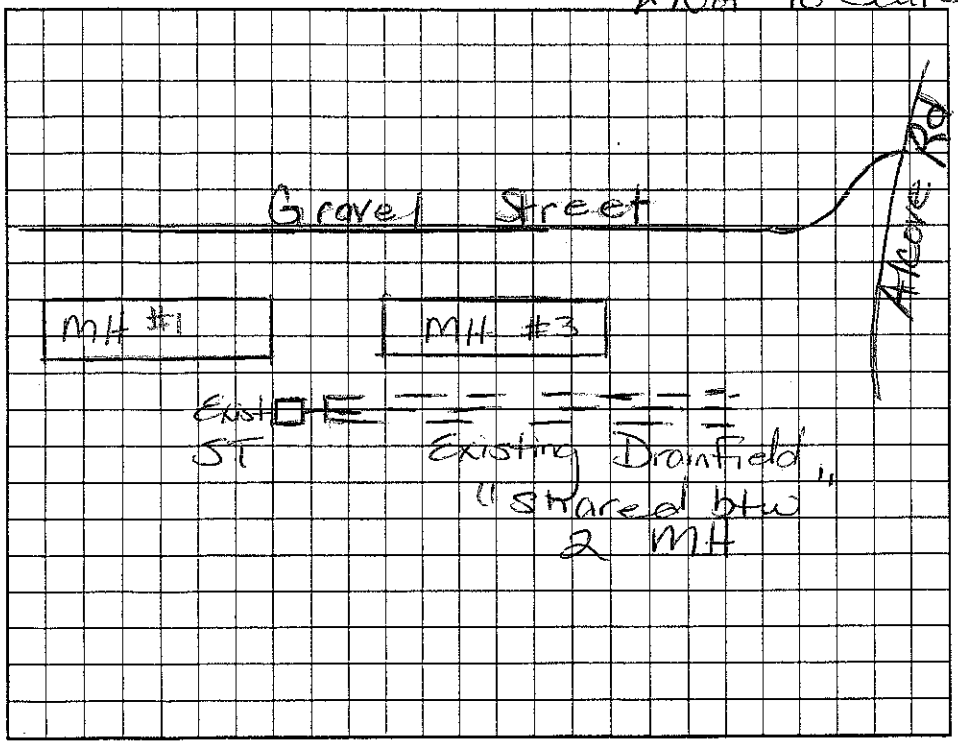

AS BUILT SKETCH

Permit can be suspended or revoked if any false information is supplied toward securing the permit/any unauthorized changes are made to the site/any unauthorized changes are made in the installation of the system. Improvement Permit with plat valid without expiration. Improvement Permit with site plan valid for sixty months. Authorization to Construct is valid for a period equal to that of Improvement Permit – not to exceed sixty months.

Signed: Kevin Davidson date

Improvement Permit by: Maria H. Colson R.S. date 6/8/04

Authorization to Construct by: date

Installed by:

Operation Permit by: date

Existing System Inspection by: Maria H. Colson R.S. date 6/8/04

HEALTH DEPT. COPY: WHITE OWNER COPY (FINAL): YELLOW OWNER COPY (INITIAL): PINK