IREDELL COUNTY HEALTH DEPARTMENT

SVILLE 704-878-5305 MOORESVILLE 704-664-5281

IMPROVEMENT PERMIT / AUTHORIZATION TO CONSTRUCT / OPERATION PERMIT / EXISTING SYSTEM INSPECTION

PERMIT# 7482 PIN# 4646-66-~~9935~~ 9920 DATE 4/10/03

OWNER OR CONTRACTOR Dawn Buskirk PHONE: Business Home 704-799-7467

ADDRESS Mooresville NC 28117

LOCATION Brawley Sch, TL Gibbs Rd, TL Hickory Hill, on Lt.

SUBDIVISION Gibbs Coup BLOCK / SECTION LOT 19 LOT AREA 1.614 AC SITE CLASS. PS DESIGN FLOW 480 L.T.A.R. 0.25

Septic Tank: 1000 (*) Gallons; STB 358 Date (*)
Pump Tank: Gallons; PT Date
Pump Make: Model Serial No.
Nitrification Field: No Fields 1 Square Feet 960 Linear Feet 320
No Lines 6 @ 54' Trench Width 24" or 36" Max Trench Bottom Depth 36" Gravel Depth —

☒ New System ☐ Repair System Type: I, II, (III), IV, V, VI
System Description: Gravity Panel Block
Repair System Description: LP Panel Block
Maintenance Agreement Required: ☐ Yes ☒ No

☒ House/Mod. Home No. Bedrooms 4
☐ Mobile Home No. Bathrooms 3
☐ Business No. Employees
☐ Other


☐ Slab ☐ Crawl Space ☐ Basement w/plumbing ☒ Basement wo/plumbing

Water Supply: ☒ Individual ☐ Public ☐ Community


Comments:/Conditions: * Remove Gravel + Pipe From Existing Drain Field carefully so not to destroy trenches Panel Blocks will go into Existing Trenches. 3 Existing lines, 1 new line

Comments:/Conditions: Gravel From Existing System Needs to be buried in designated area No deeper than 36" - spread gravel Evenly HD needs to see before Covering

INITIAL SITE SKETCH

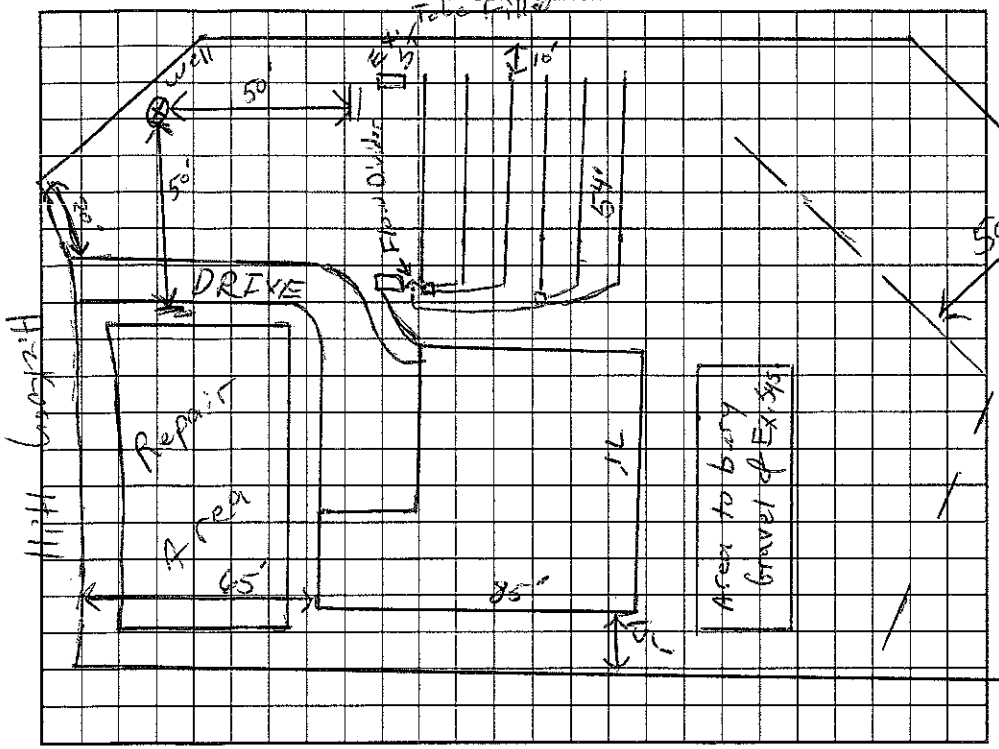

AS BUILT SKETCH

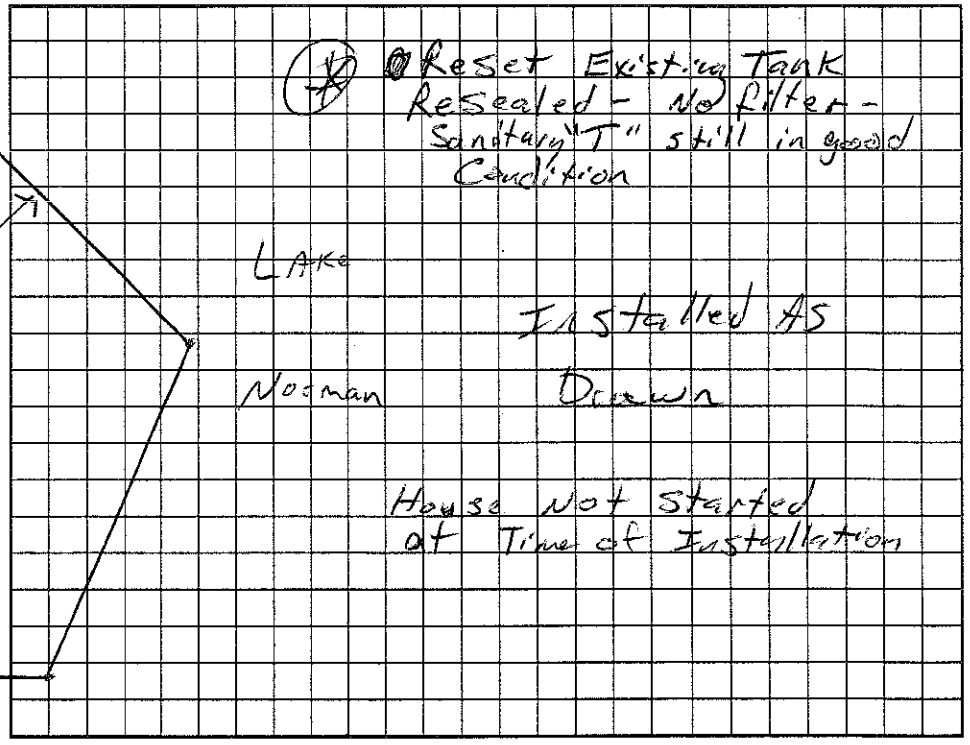

Permit can be suspended or revoked if any false information is supplied toward securing the permit/any unauthorized changes are made to the site/any unauthorized changes are made in the installation of the system. Improvement Permit with plat valid without expiration. Improvement Permit with site plan valid for sixty months. Authorization to Construct is valid for a period equal to that of Improvement Permit – not to exceed sixty months.

Signed: Dawn Buskirk date 4/14/03 Installed by: Problem Solvers

Improvement Permit by: RS date 4/10/03 Operation Permit by: RS date 10/01/03

Authorization to Construct by: RS date 4/10/03 Existing System Inspection by: date

HEALTH DEPT. COPY: WHITE OWNER COPY (FINAL): YELLOW OWNER COPY (INITIAL): PINK