Jerry 704 506 9074

IREDELL COUNTY HEALTH DEPARTMENT - *ENVIRONMENTAL HEALTH* ☐ STATESVILLE OFFICE 704-878-5305 ☑ MOORESVILLE OFFICE 704-664-5281

IMPROVEMENT PERMIT / AUTHORIZATION TO CONSTRUCT / OPERATION PERMIT / EXISTING SYSTEM INSPECTION

PERMIT # 169548 PIN # 4646 67 5078 DATE November 18, 2011

OWNER Si Yong Chun & Mi OK Chun/Lent APPLICANT: same/Annabelle Lenthardt PHONE: Home/Cell # Business # 704-846-7966

SITE ADDRESS 176 Hickory Hill Rd Mooresville OWNER / APPLICANT ADDRESS 8208 Peyton Randolph Dr Charlotte NC 28277

SITE DIRECTIONS Brawley School Rd TL Silver Hook TR Hickory Hill on right

SUBDIVISION BLOCK / SECTION LOT # LOT AREA .66 Ac. DESIGN FLOW 360 gpd L.T.A.R. .39 gpd/ft² .25 Repair

Septic Tank 1000 Gallons: STB 925 Date 9-7-12

Pump Tank 1000 Gallons: PT 302 Date 10-12-12

Pump Make Model Serial #

No. Nitrification Fields: 1 No. Lines 5 Linear Feet 200

Trench Width 24" Max. Trench Bottom Depth 36" Gravel Depth NA

☒ New System ☐ Repair ☐ Expansion System Type I II (III) IV V VI

System Description: PPBPS PM

Repair System Description: LP PPBPS Pretreat TS-II

Maintenance Agreement Required ☐ YES ☒ NO

☐ GRAVITY ☒ PRESSURE

☒ Residence No. Bedrooms 3

☐ Business No. Persons 6

☐ Other No. Employees

☐ Slab ☒ Crawl Space

☐ Basement w/plumbing ☐ Basement w/o plumbing

Water Supply: ☒ Private ☐ Public ☐ Community


Comments / Conditions

Tanks, lines & pressure checked by BA
Elect & alarm checked by MD

INITIAL SITE SKETCH

See Plan from
Rollans Soil & Environmental
Services, Inc.
Approved by ICHD

AS BUILT SKETCH

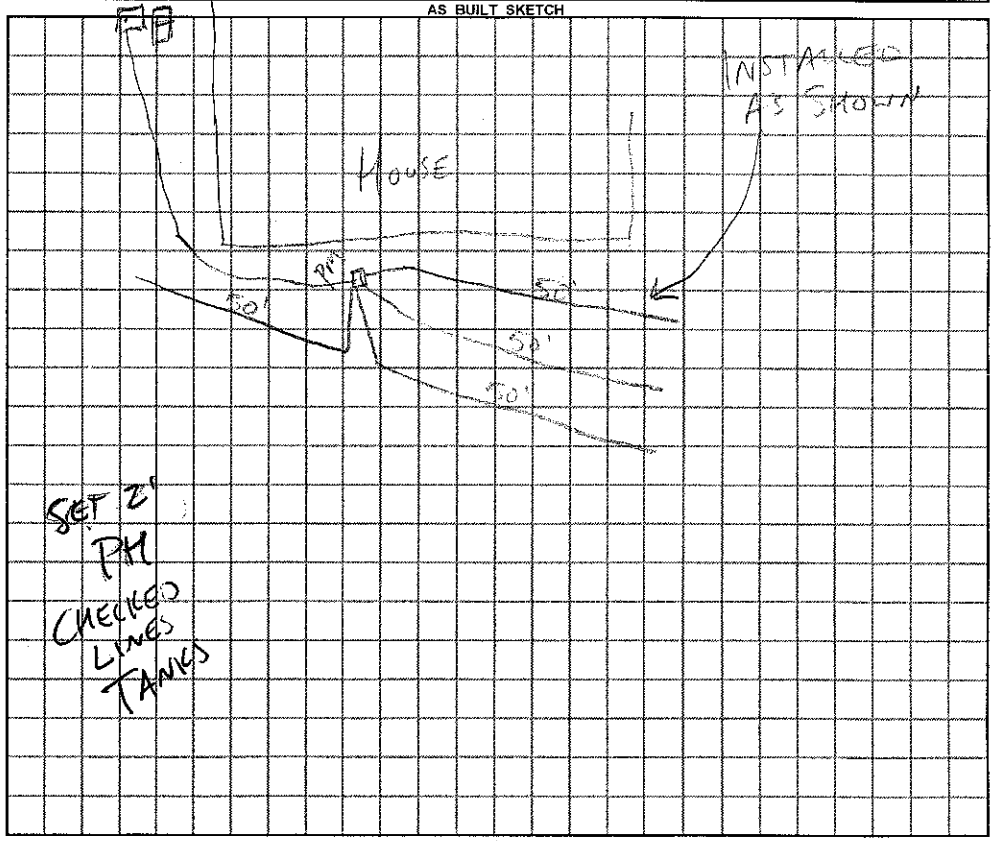

Permit can be suspended or revoked if any false information is supplied toward securing the permit / any unauthorized changes are made to the site / any unauthorized changes are made in the installation of the system.

☐ ***IMPROVEMENT PERMIT*** with plat valid without expiration. ☒ ***IMPROVEMENT PERMIT*** with plat valid without expiration. site plan valid 60 mo. ☒ ***AUTHORIZATION TO CONSTRUCT*** valid for period equal to IMPROVEMENT PERMIT--not to exceed 60 mo.

Owner / Applicant Signature: J. Lenthardt Date 7/18/12

IMPROVEMENT PERMIT by: Judy Mecklly REHS Date 11-18-11

AUTHORIZATION TO CONSTRUCT by: Judy Mecklly REHS Date 6-27-12

YOU SHOULD CONTACT A LOCATOR SERVICE PRIOR TO ANY EXCAVATION

Installed by: ROWAN

OPERATION PERMIT by: Maria Hilse REHS Date 2/21/13

Existing System Inspected by: REHS Date

White Copy – Environmental Health YELLOW COPY (Final) Owner / Applicant PINK COPY (Initial) Owner / Applicant