IRED

L COUNTY HEALTH DEPARTMENT

STATESVILLE 704-878-5305 Sod Paid MOORESVILLE 704-664-5281

IMPROVEMENT PERMIT / AUTHORIZATION TO CONSTRUCT / OPERATION PERMIT / EXISTING SYSTEM INSPECTION

DATE 12/3/02

PERMIT# 109844 PIN# 4646 67 6085

OWNER OR CONTRACTOR HANGTAO HAN PHONE: Business _____ Home _____

ADDRESS 204 CHANDALEUR Dr. MOORESVILLE, NC 28117

LOCATION 1100 TL GIBBS RD. STRAIGHT TO LAKE TR ON (L) IN CURVE 178 HICKORY HILL Dr.

SUBDIVISION ~~GIBBS COVE~~ BLOCK / SECTION _____ LOT ~~63~~ LOT AREA .55 Ac SITE CLASS. PS DESIGN FLOW 480 L.T.A.R. .3

Septic Tank: 1000 Gallons; STB _____ Date 11/7/02

Pump Tank: _____ Gallons; PT _____ Date _____

Pump Make: _____ Model _____ Serial No. _____

Nitrification Field: No Fields 1 Square Feet 532 ✱ Linear Feet 266 ✱

No Lines 8 @ 33.2 Trench Width 2' Max Trench Bottom Depth (30") Gravel Depth No

☒ New System ☐ Repair System Type: I, II, (III) IV, V, VI

System Description: FLOWDIVIDER-2 DBOXES - PPBRS

Repair System Description: PRES DOSED 16" PPBRS

Maintenance Agreement Required: ☐ Yes ☒ No

☐ Slab ☐ Crawl Space ☒ Basement w/plumbing ☐ Basement wo/plumbing

☒ House/Mod. Home No. Bedrooms 4

☐ Mobile Home No. Bathrooms 3.5

☐ Business No. Employees _____

☐ Other _____


Water Supply: ☒ Individual ☐ Public ☐ Community

ON LOT TO RIGHT


Comments:/Conditions: 50% reduced original system and repair system. Well to be located on front of Lot 63.

Comments:/Conditions: This system installed when ground was too wet. Recommend allowing trenches to dry out before completing the covering operation

INITIAL SITE SKETCH (1" = 40')

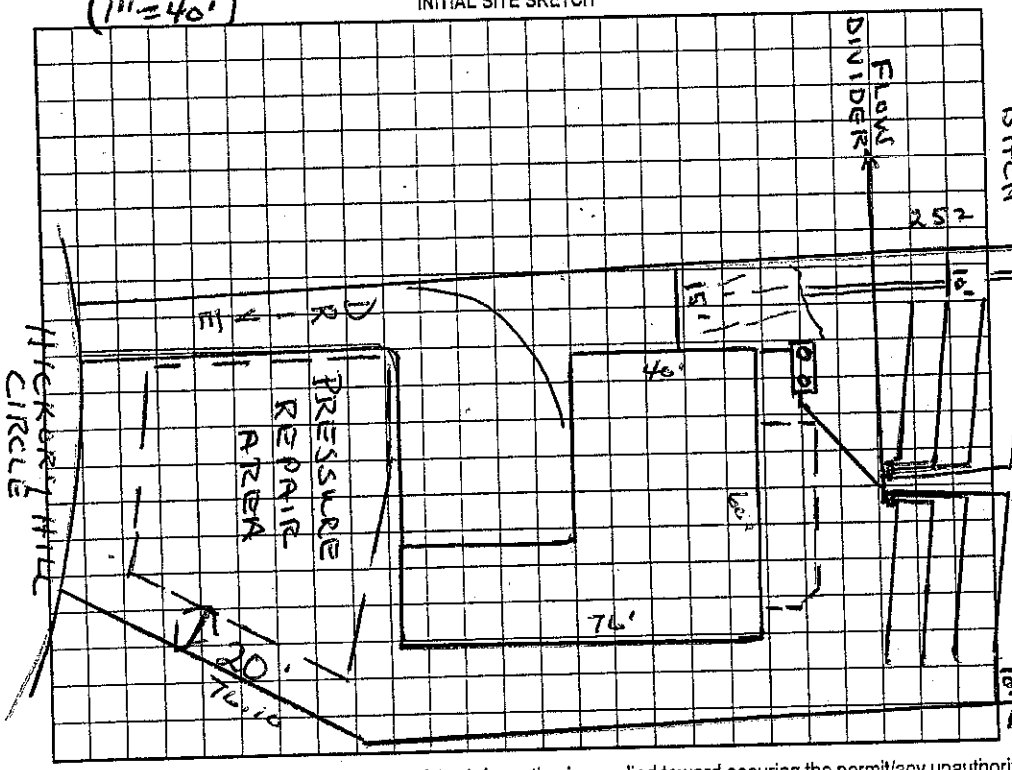

AS BUILT SKETCH

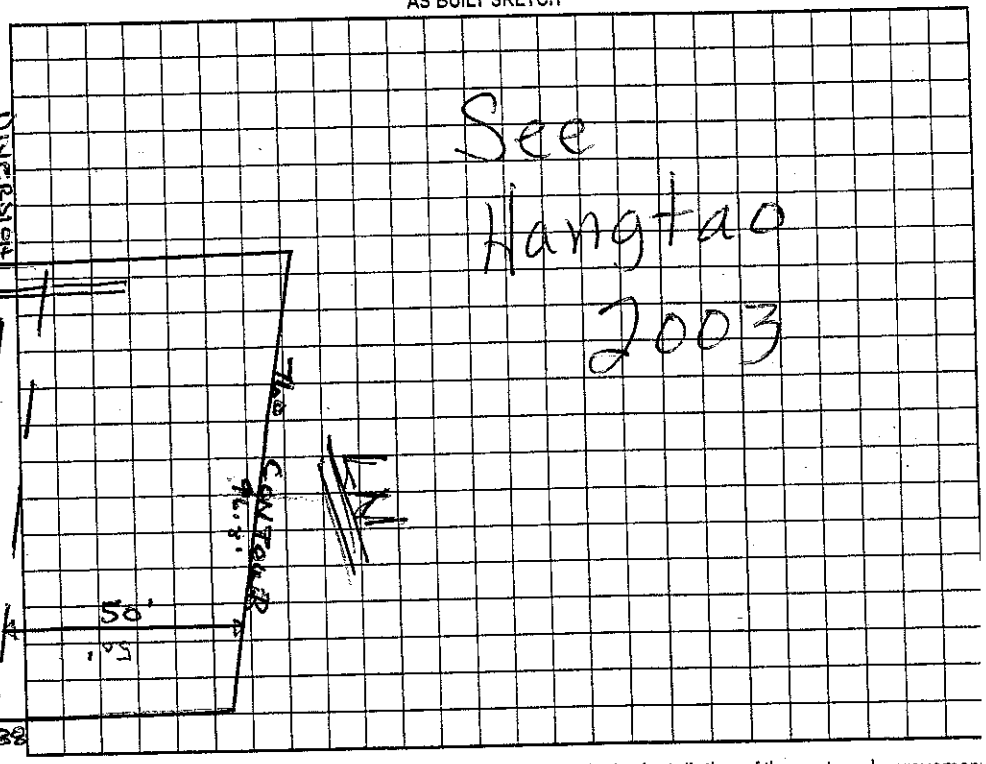

Permit can be suspended or revoked if any false information is supplied toward securing the permit/any unauthorized changes are made to the site/any unauthorized changes are made in the installation of the system. Improvement Permit with plat valid without expiration. Improvement Permit with site plan valid for sixty months. Authorization to Construct is valid for a period equal to that of Improvement Permit – not to exceed sixty months.

Signed: ✱ [redacted] date 12/4/02

Improvement Permit by: Wesley Sparks R.S. date 12/3/02

Authorization to Construct by: Wesley Sparks R.S. date 12/3/02

Installed by: Jim Farthing

Operation Permit by: Wesley Sparks R.S. date 11/13/03

Existing System Inspection by: _____ date _____

OWNER COPY (FINAL): YELLOW OWNER COPY (INITIAL): PINK