IREDELL COUNTY HEALTH DEPARTMENT

STATESVILLE 704-878-5305 130.00 Pg 9 MOORESVILLE 704-664-5281

IMPROVEMENT PERMIT / AUTHORIZATION TO CONSTRUCT / OPERATION PERMIT / EXISTING SYSTEM INSPECTION

PERMIT# 127226 PIN# 4646 67 8301 .000 DATE 6/28/05

OWNER OR CONTRACTOR Mark H Moseley PHONE: Business 704-321-1190 Home

ADDRESS 7703 Seton House Ln. Charlotte, NC 28277

LOCATION Hickory Hill Rd., Brandy Sch TL Gilbert Rd TR Apple Blossom TL Hickory Hill Rd on (L) at water

SUBDIVISION Gilbert Cove BLOCK / SECTION LOT 50 LOT AREA .855 SITE CLASS PS DESIGN FLOW 480 L.T.A.R. .3

Septic Tank: 1000 Gallons; STB 3112 Date 2/12/07

Pump Tank: 1000 Gallons; PT 283 Date 2/10/07

Pump Make: Goulds Model PES1M Serial No.

Nitrification Field: No Fields 1 Square Feet 1200 Linear Feet 400

No Lines 4@100' Trench Width 3' Max Trench Bottom Depth 3' Gravel Depth No

☒ New System ☐ Repair System Type: I (II) III IV V VI

System Description: PM → 2570 Reduction

Repair System Description: Pressure Dosed 1" PPBAS

Maintenance Agreement Required: ☐ Yes ☒ No

☒ House/Mod. Home No. Bedrooms 4

☐ Mobile Home No. Bathrooms 4

☐ Business No. Employees

☐ Other

☐ Slab ☒ Crawl Space ☐ Basement w/plumbing ☐ Basement wo/plumbing


Water Supply: ☒ Individual ☐ Public ☐ Community

Comments:/Conditions:


Comments:/Conditions:

(1" = 50')

INITIAL SITE SKETCH

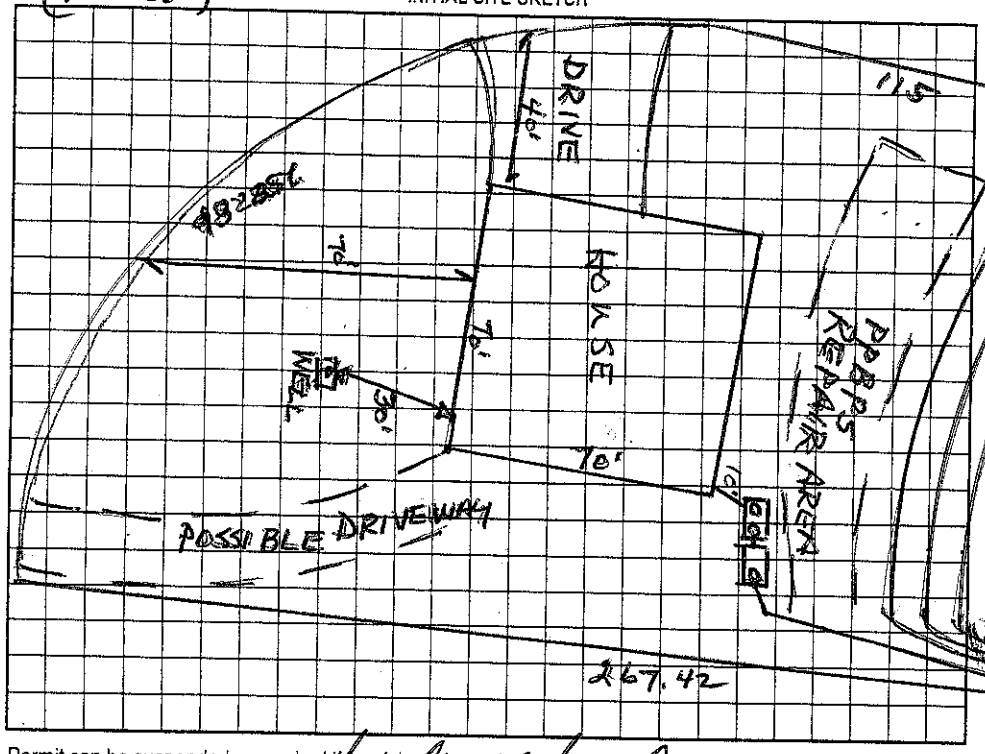

AS BUILT SKETCH

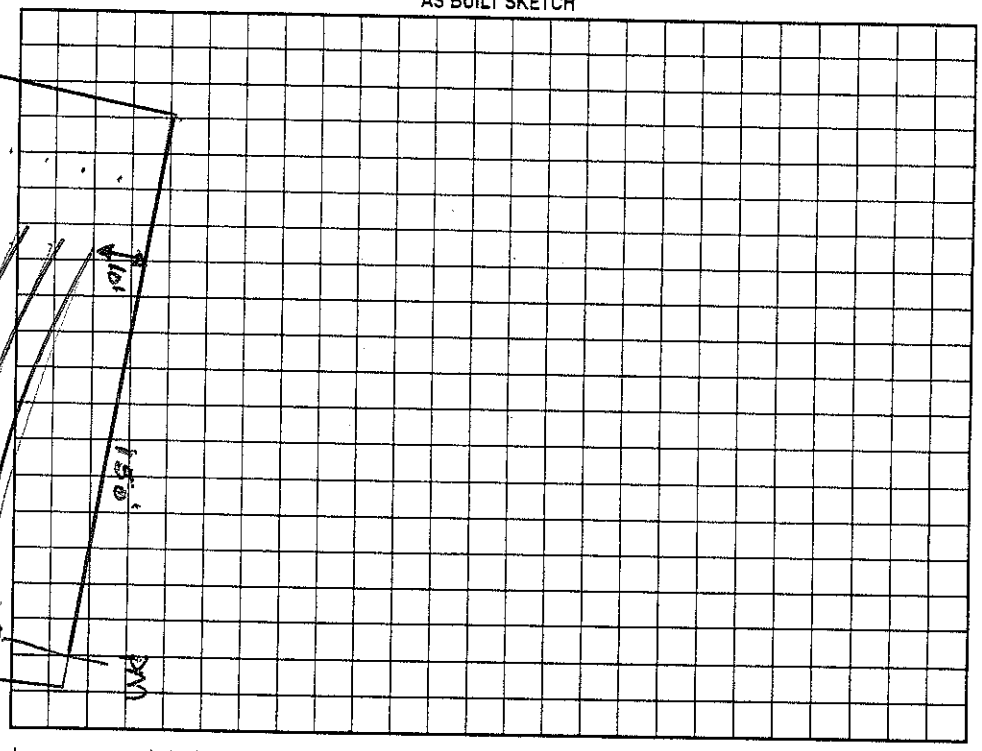

Permit can be suspended or revoked if any false information is supplied toward securing the permit/any unauthorized changes are made to the site/any unauthorized changes are made in the installation of the system. Improvement Permit with plat valid without expiration. Improvement Permit with site plan valid for sixty months. Authorization to Construct is valid for a period equal to that of Improvement Permit – not to exceed sixty months.

Signed: X Mark Moseley date 7/12/05

Improvement Permit by: Wesley Sparks RS date 6/28/05

Authorization to Construct by: Wesley Sparks RS date 6/28/05

Installed by: Richard Abernathy

Operation Permit by: Joseph E Wolf date 6/26/07

Existing System Inspection by: date

HEALTH DEPT. COPY: WHITE OWNER COPY (FINAL): YELLOW OWNER COPY (INITIAL): PINK