IREDELL COUNTY HEALTH DEPARTMENT - *ENVIRONMENTAL HEALTH* ☐ STATESVILLE OFFICE 704-878-5305 ☐ MOORESVILLE OFFICE 704-664-5281

IMPROVEMENT PERMIT / AUTHORIZATION TO CONSTRUCT / OPERATION PERMIT / EXISTING SYSTEM INSPECTION

PERMIT # 172218 PIN # 4646678592 DATE 5-29-2012

OWNER James & Pam Harrah APPLICANT: Pam Harrah PHONE: Home/Cell # 7049061762 Business # 7049099975

SITE ADDRESS 155 Hickory Hill Rd M'ville OWNER / APPLICANT ADDRESS Same

SITE DIRECTIONS Brawley School Rd TL Silver Hook TR Apple Blossom TL Hickory Hill on left

SUBDIVISION Gibbs Cove BLOCK / SECTION LOT # 49 LOT AREA DESIGN FLOW 480 gpd L.T.A.R.

Existing

Septic Tank 1000 Gallons: STB Date

Pump Tank 1000 Gallons: PT Date

Pump Make Model Serial #

No. Nitrification Fields: 1 No. Lines 4 Linear Feet 400'

Trench Width 36" Max. Trench Bottom Depth 36" Gravel Depth N/A

☐ New System ☐ Repair ☐ Expansion System Type I II III IV V VI

System Description: Existing Pump - PM - 25% Reduction

Repair System Description: LP Panel Blk

Maintenance Agreement Required ☐ YES ☒ NO Not initially

☐ GRAVITY ☒ PRESSURE

☒ Residence No. Bedrooms 4

☐ Business No. Persons

☐ Other No. Employees

☐ Slab ☐ Crawl Space

☐ Basement w/plumbing ☐ Basement w/o plumbing


Water Supply: ☒ Private ☐ Public ☐ Community

Comments / Conditions

Existing Septic System appears to be functioning okay at time of inspection. Swimming Pool (Ext. must be at least 15ft from Septic System, (Including "Repair Area")

PL 222

INITIAL SITE SKETCH

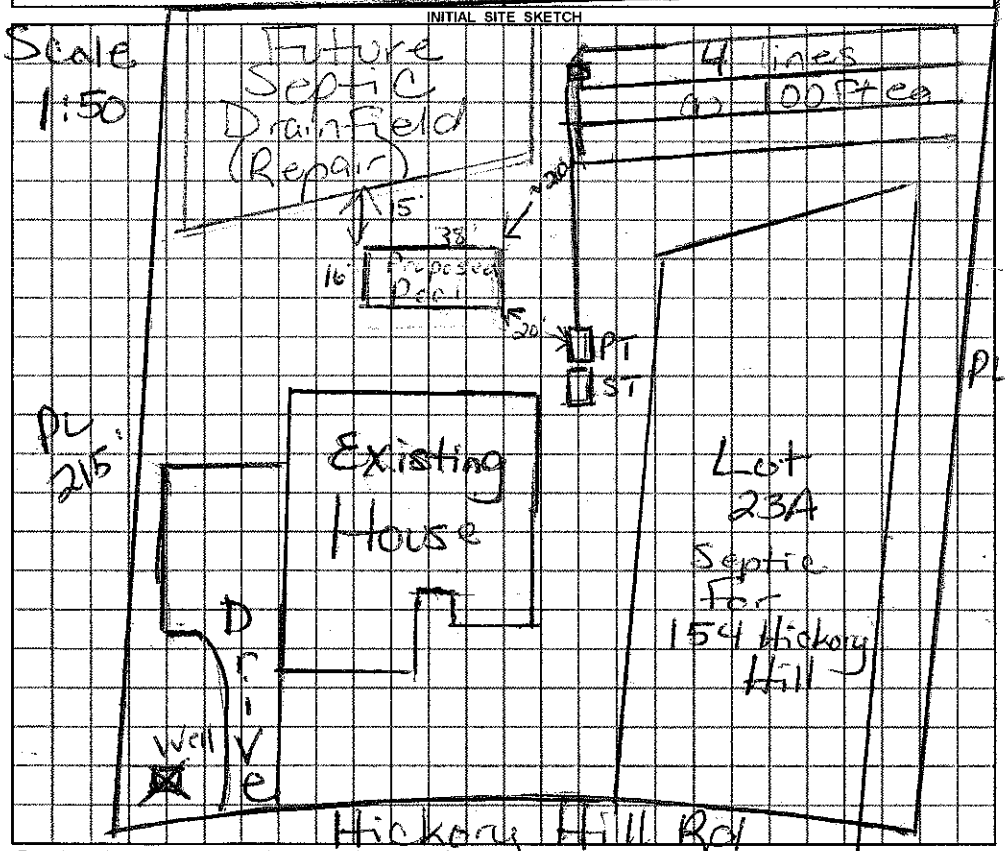

AS BUILT SKETCH

Permit can be suspended or revoked if any false information is supplied toward securing the permit / any unauthorized changes are made to the site / any unauthorized changes are made in the installation of the system.

☐ ***IMPROVEMENT PERMIT*** with plat valid without expiration. ☐ ***IMPROVEMENT PERMIT*** with ~~plat valid without expiration.~~ site plan valid 60 mo. ☐ ***AUTHORIZATION TO CONSTRUCT*** valid for period equal to IMPROVEMENT PERMIT--not to exceed 60 mo.

Owner / Applicant Signature: X James Harrah Date

Installed by: Richard Abernathy 12/17/2007

IMPROVEMENT PERMIT by: REHS Date

OPERATION PERMIT by: REHS Date

AUTHORIZATION TO CONSTRUCT by: REHS Date

Existing System Inspected by: REHS Date 5/29/12

YOU SHOULD CONTACT A LOCATOR SERVICE PRIOR TO ANY EXCAVATION

White Copy – Environmental Health YELLOW COPY (Final) Owner / Applicant PINK COPY (Initial) Owner / Applicant