IREDELL COUNTY HEALTH DEPARTMENT

STATESVILLE 704-878-5305 MOORESVILLE 704-664-5281

IMPROVEMENT PERMIT / AUTHORIZATION TO CONSTRUCT / OPERATION PERMIT / EXISTING SYSTEM INSPECTION

3150 Pd 10.00

PERMIT# 127227 PIN# 4646 67 9225.000 DATE 6/28/05

OWNER OR CONTRACTOR Virginia Berglund PHONE: Business 704-362-6443 Home

ADDRESS 7703 Antique Honey Ln. Charlotte NC 28277

LOCATION Hickory Hill Dr. ; Brawley School Rd, TL Gibbs Rd TR Apple Blossom TL Hickory Hill, at Lake on L

SUBDIVISION Gibbs Cove BLOCK / SECTION LOT 51 LOT AREA .719 Ac SITE CLASS: PS DESIGN FLOW 480 L.T.A.R. .3

Septic Tank: 1000 Gallons; STB 325 Date 11-5-06
Pump Tank: 1000 Gallons; PT 302 Date 9-10-06
Pump Make: Zoller Model N152 Serial No.
Nitrification Field: No Fields 1 Square Feet 800 Linear Feet 267
No Lines 5@53 Trench Width 2-3' Max Trench Bottom Depth 3' Gravel Depth No

☒ New System ☐ Repair System Type: I, II, III, IV, V, VI
System Description: Pres Dosed - 16" PBBRS
Repair System Description: Same Type
Maintenance Agreement Required: ☒ Yes ☐ No

☒ House/Mod. Home No. Bedrooms 4
☐ Mobile Home No. Bathrooms 4
☐ Business No. Employees
☐ Other
☐ Slab ☒ Crawl Space ☐ Basement w/plumbing ☐ Basement wo/plumbing


Water Supply: ☒ Individual ☐ Public ☐ Community

Comments:/Conditions:

Comments:/Conditions: Installed Drainlines as Shown
2/8/07 Checked Tanks, Lines & pressure

(1" = 50')

INITIAL SITE SKETCH

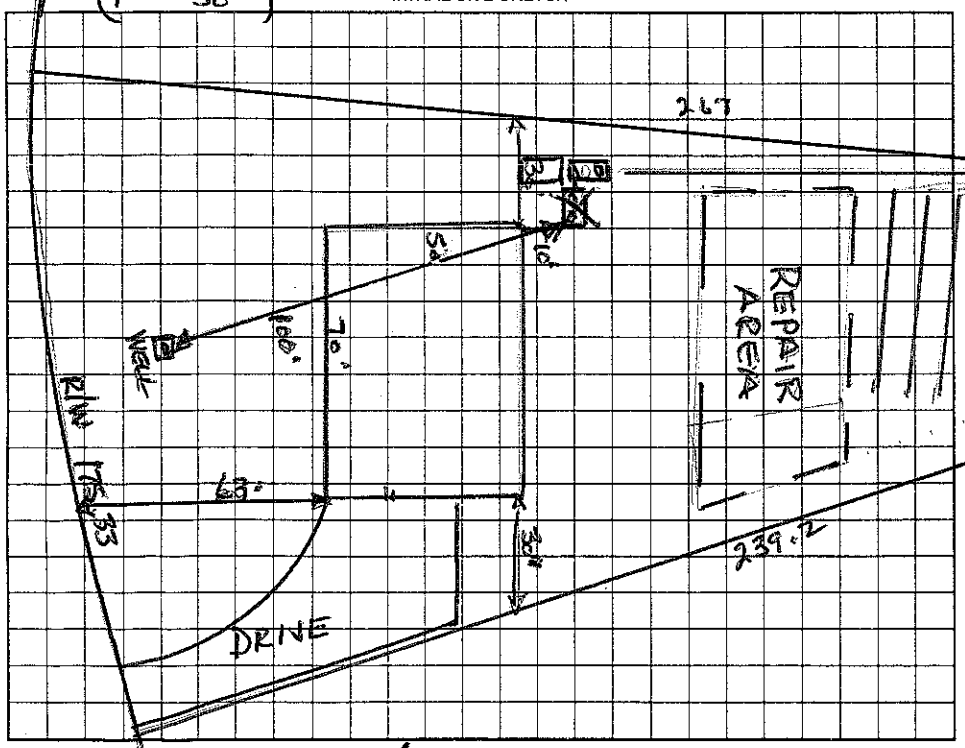

AS BUILT SKETCH

Permit can be suspended or revoked if any false information is supplied toward securing the permit/any unauthorized changes are made to the site/any unauthorized changes are made in the installation of the system. Improvement Permit with plat valid without expiration. Improvement Permit with site plan valid for sixty months. Authorization to Construct is valid for a period equal to that of Improvement Permit – not to exceed sixty months.

Signed: X date

Installed by: Rowan Septic

Improvement Permit by: Wesley Sparks RS date 6/28/05

Operation Permit by: Mark Dobson RS date 3/14/07

Authorization to Construct by: Wesley Sparks RS. date 6/28/05

Existing System Inspection by: date

HEALTH DEPT. COPY: WHITE OWNER COPY (FINAL): YELLOW OWNER COPY (INITIAL): PINK