IREDELL COUNTY HEALTH DEPARTMENT

STATESVILLE 704-878-5305 130.00 Paid 3.30 MOORESVILLE 704-664-5281

IMPROVEMENT PERMIT / AUTHORIZATION TO CONSTRUCT / OPERATION PERMIT / EXISTING SYSTEM INSPECTION

PERMIT# 118737 PIN# 4646 67 9647 DATE 3/10/04

OWNER OR CONTRACTOR Thomas R. Principe PHONE: Business 704-661-1333 Home

ADDRESS 8220 Quantas Ln. Charlotte, NC 28227

LOCATION Hickory Hill Rd. on (E) Lugay Lake

SUBDIVISION Hicks Cove BLOCK / SECTION LOT 48 LOT AREA .6715 SITE CLASS PS DESIGN FLOW 480 L.T.A.R. .3

Septic Tank: 1000 Gallons; STB 825 Date 11/9/05
Pump Tank: 1000 Gallons; PT 302 Date 11/9/04
Pump Make: Zoeller Model N98 Serial No.
Nitrification Field: No Fields 1 Square Feet 1200 Linear Feet 400
No Lines 4@100' Trench Width 3' Max Trench Bottom Depth 3' Gravel Depth No

[X] New System [ ] Repair System Type: I, II, (III) IV, V, VI
System Description: Pres Man. → Type 3
Repair System Description: Same Type
Maintenance Agreement Required: [ ] Yes [X] No

[X] House/Mod. Home No. Bedrooms 4
[ ] Mobile Home No. Bathrooms 3
[ ] Business No. Employees
[ ] Other
[ ] Slab [X] Crawl Space [ ] Basement w/plumbing [ ] Basement wo/plumbing


Water Supply: [X] Individual [ ] Public [ ] Community

Comments:/Conditions:

Comments:/Conditions:

(1" = 50')

INITIAL SITE SKETCH

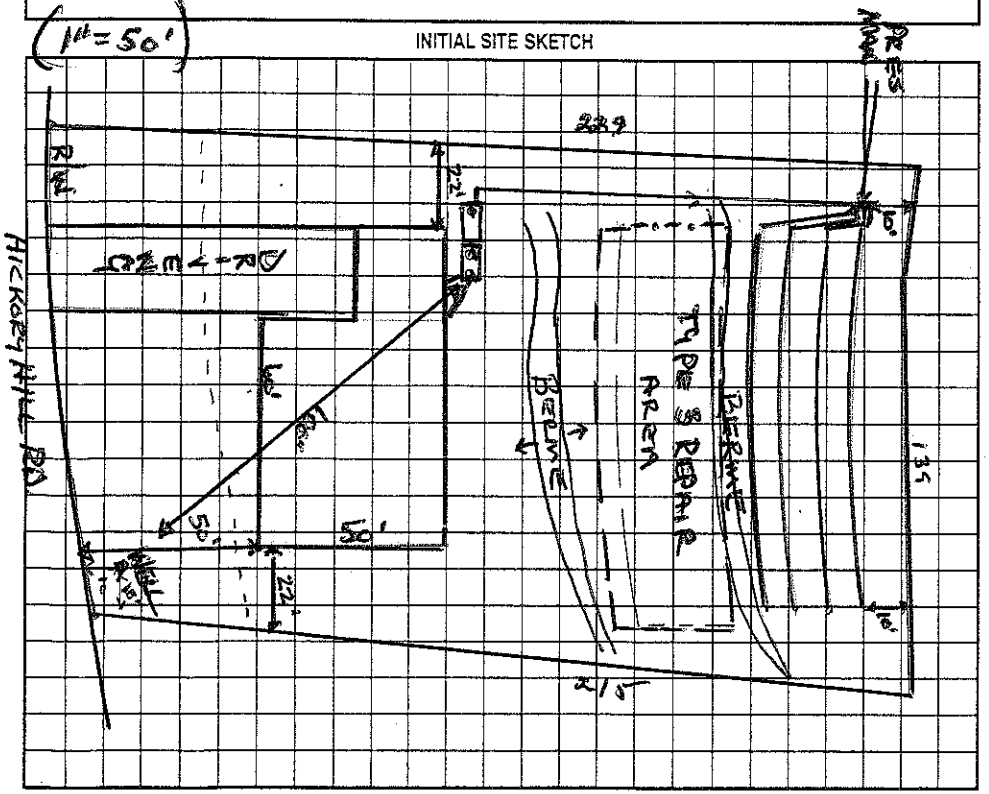

AS BUILT SKETCH

In Cultrators Installed

Permit can be suspended or revoked if any false information is supplied toward securing the permit/any unauthorized changes are made to the site/any unauthorized changes are made in the installation of the system. Improvement Permit with plat valid without expiration. Improvement Permit with site plan valid for sixty months. Authorization to Construct is valid for a period equal to that of Improvement Permit – not to exceed sixty months.

Signed: * Randy Principe date 8-30-04 Installed by: Bowan Septic

Improvement Permit by: Wesley Sparks R.S. date 3/10/04 Operation Permit by: [signature] R.S. date 5/12/05

Authorization to Construct by: Wesley Sparks R.S. date 9/8/04 Existing System Inspection by: date

HEALTH DEPT. COPY: WHITE OWNER COPY (FINAL): YELLOW OWNER COPY (INITIAL): PINK