IREDELL COUNTY HEALTH DEPARTMENT

STATESVILLE 704-878-5305 90.00 Paid MOORESVILLE 704-664-5281

IMPROVEMENT PERMIT / AUTHORIZATION TO CONSTRUCT / OPERATION PERMIT / EXISTING SYSTEM INSPECTION

PERMIT# 129920 PIN# 4646 67 9860.000 DATE 6/28/05

OWNER OR CONTRACTOR Velco Dev. Inc. PHONE: Business 704-819-8618 Home

ADDRESS #218 407 Brawley Sch. Rd. Mooresville, NC. 28117

LOCATION Hickory Hill Dr., 1100 TL Dobbs Rd. TR Apple Blossom Tl Hickory Hill, on (L) B4 lake

SUBDIVISION Dobbs Cove BLOCK / SECTION 2 LOT 47 LOT AREA .70AC SITE CLASS. PS DESIGN FLOW 480 L.T.A.R. .3

Septic Tank: 1000 Gallons; STB 825 Date 11/2/06
Pump Tank: 1000 Gallons; PT 302 Date 1/6/06
Pump Make: Zoeller Model N152 Serial No.
Nitrification Field: No Fields 1 Square Feet 1200 Linear Feet 400
No Lines 4 @ 100 Trench Width 3' Max Trench Bottom Depth 3' Gravel Depth No

☒ New System ☐ Repair System Type: I, II, (III), IV, V, VI
System Description: Pres Man. → 25% Reduced
Repair System Description: Same Type
Maintenance Agreement Required: ☐ Yes ☒ No

☒ House/Mod. Home No. Bedrooms 4
☐ Mobile Home No. Bathrooms 4
☐ Business No. Employees
☐ Other
☐ Slab ☒ Crawl Space ☐ Basement w/plumbing ☐ Basement wo/plumbing


Water Supply: ☒ Individual ☐ Public ☐ Community

Comments:/Conditions:


Comments:/Conditions:

1" = 40'

INITIAL SITE SKETCH

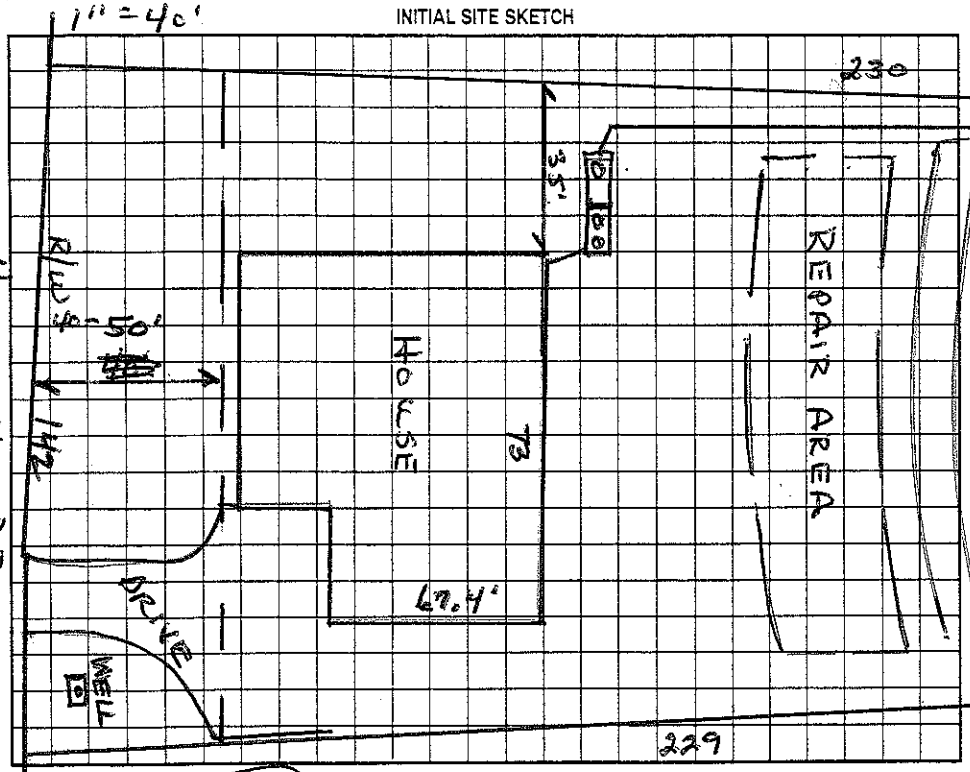

AS BUILT SKETCH

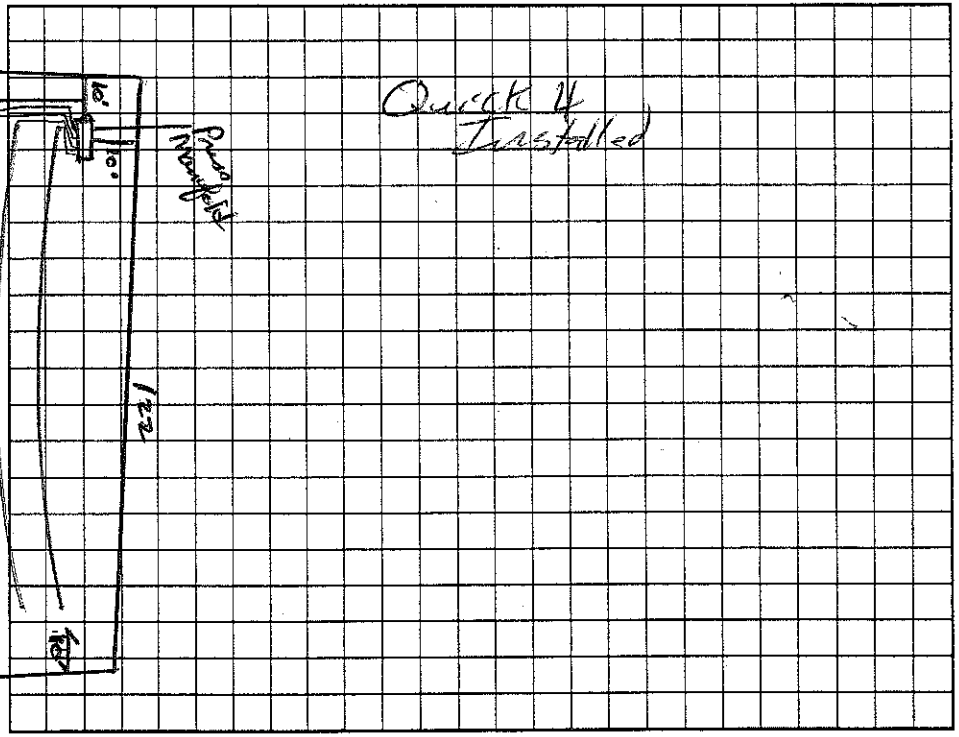

Permit can be suspended or revoked if any false information is supplied toward securing the permit/any unauthorized changes are made to the site/any unauthorized changes are made in the installation of the system. Improvement Permit with plat valid without expiration. Improvement Permit with site plan valid for sixty months. Authorization to Construct is valid for a period equal to that of Improvement Permit – not to exceed sixty months.

Signed: * date 7-11-05

Improvement Permit by: Wendy Sparks RS date 7/11/05

Authorization to Construct by: Wendy Sparks RS date 7/11/05

Installed by: Rowan Sept. Inc

Operation Permit by: Wendy Sparks R.S. date 6/5/06

Existing System Inspection by: date

HEALTH DEPT. COPY: WHITE OWNER COPY (FINAL): YELLOW OWNER COPY (INITIAL): PINK