IREDELL COUNTY HEALTH DEPARTMENT

STATESVILLE 704-878-5305 MOORESVILLE 704-664-5281

IMPROVEMENT PERMIT / AUTHORIZATION TO CONSTRUCT / OPERATION PERMIT / EXISTING SYSTEM INSPECTION

PERMIT# 7703 100620 PIN# 4646687111 DATE 6/5/2000

OWNER OR CONTRACTOR Julie & John Cole PHONE: Business 948-1451 Home 662-3060 or 1906-3511

ADDRESS 124 Blackberry Lane Mooresville, NC 28117 134 Hickory Hill

LOCATION Brawley School Rd Tl Gibbs Cove TR Apple Blossom Dr Tl Hickory Hill Circle

SUBDIVISION Gibbs Cove BLOCK / SECTION ____ LOT 68 LOT AREA ____ SITE CLASS. PS DESIGN FLOW 360 gpd L.T.A.R. .3

Septic Tank: 1000 Gallons; STB 794 Date 2-7-02

Pump Tank: 1000 Gallons; PT 283 Date 7-14-01

Pump Make: ____ Model ____ Serial No. ____

Nitrification Field: No Fields 1 Square Feet ____ Linear Feet 320'

No Lines 8 at 40' Trench Width 36" Max Trench Bottom Depth 21" Gravel Depth N/A

☒ New System ☐ Repair System Type: I, II, III, IV, V, VI

System Description: Pump (PM) 25% Reduction

Repair System Description: Pump - Innovative

Maintenance Agreement Required: ☐ Yes ☐ No

☒ House/Mod. Home No. Bedrooms 3

☐ Mobile Home No. Bathrooms 4.5

☐ Business No. Employees ____

☐ Other ____

☐ Slab ☐ Crawl Space ☒ Basement w/plumbing ☐ Basement wo/plumbing

Water Supply: ☒ Individual ☐ Public ☐ Community

Comments:/Conditions: Keep Septic System at least 10' PL upgradient of basement & 50' from lake & well. Well should be at least 25' from House, 50' from lake & at least 50' from Septic


Comments:/Conditions:

6-23-00 Reviewed house plan (slightly larger - deeper than shown but not as wide - driveway to go along right side property line

Tanks Set Lines Elect. alarm, Press. Checked 4/5/2002 Checked 3/25/2002

Drainline Installed as 11 Plastic Chambers

INITIAL SITE SKETCH

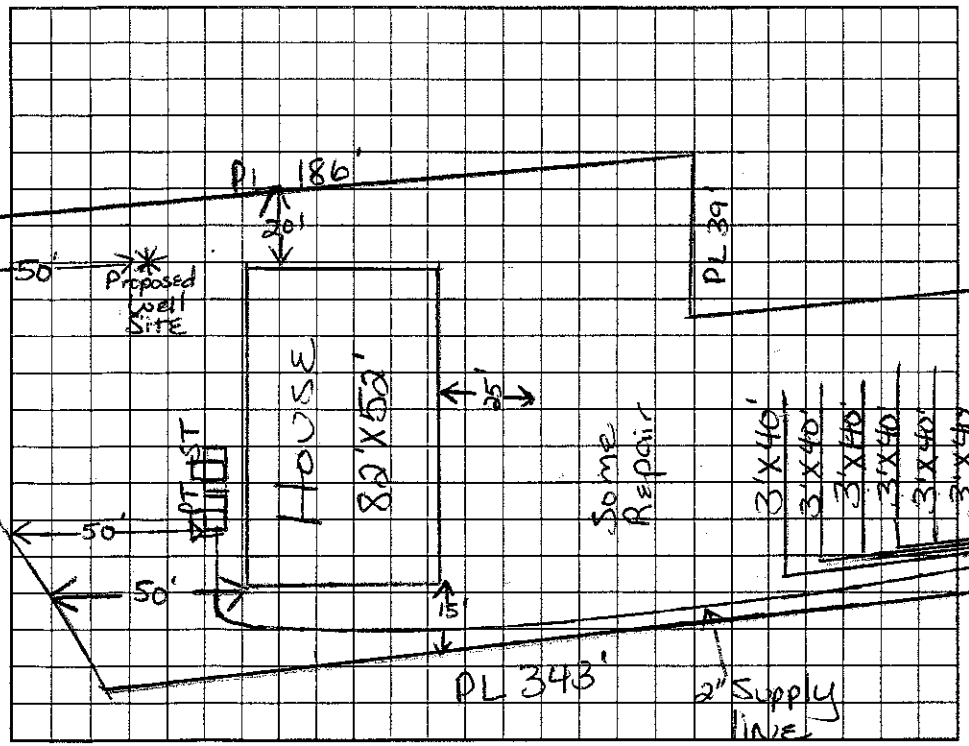

AS BUILT SKETCH

Permit can be suspended or revoked if any false information is supplied toward securing the permit/any unauthorized changes are made to the site/any unauthorized changes are made in the installation of the system. Improvement Permit with plat valid without expiration; Improvement Permit with site plan valid for sixty months. Authorization to Construct is valid for a period equal to that of Improvement Permit – not to exceed sixty months.

Signed: ____ date 6/8/00 Installed by: Curt Dunning RS

Improvement Permit by: Marvin H. Dotson RS date 6/5/2000 Operation Permit by: Marvin H. Dotson RS date 4/5/2

Authorization to Construct by: Marvin H. Dotson RS date 6-23-00 Existing System Inspection by: ____ date ____

HEALTH DEPT. COPY: WHITE OWNER COPY (FINAL): YELLOW OWNER COPY (INITIAL): PINK