IREDELL COUNTY HEALTH DEPARTMENT

STATESVILLE 704-878-5305 — MOORESVILLE 704-664-5281

IMPROVEMENT PERMIT / AUTHORIZATION TO CONSTRUCT / OPERATION PERMIT / EXISTING SYSTEM INSPECTION

PERMIT# 19994 ~~21773~~ PIN# ~~4646 78 2324~~ 4646-68-7615 662-6460 DATE 1/28/04

OWNER OR CONTRACTOR Kenneth Beaver Homes PHONE: Business ~~704 662 6480~~ Home

ADDRESS PO Box 3398 Mooresville, NC. 28117

LOCATION 1100 Tl Dibbs Rd. TR Apple Blossom on (R) TR Donnive Ln. last lot on (R)

SUBDIVISION Dibbs Cove BLOCK / SECTION LOT 26 LOT AREA ~1.8Ac SITE CLASS PS DESIGN FLOW 480 L.T.A.R. .3

Septic Tank: 1000 Gallons; STB TANK Date 7/13/04
Pump Tank: 1000 Gallons; PT 27 Date 7/27/04
Pump Make: Goulds Model WE07121HV Serial No. F04/03126
Nitrification Field: No Fields 1 Square Feet 536 Linear Feet 268
No Lines 4@67' Trench Width 2' Max Trench Bottom Depth 3 Gravel Depth NA

[X] New System [ ] Repair System Type: I, II, III, (IV), V, VI
System Description: Pres. Dosed - 16" PPBRS
Repair System Description: Same Type
Maintenance Agreement Required: [X] Yes [ ] No


[X] House/Mod. Home [ ] Mobile Home [ ] Business [ ] Other
No. Bedrooms 4 No. Bathrooms 5 No. Employees
[ ] Slab [ ] Crawl Space [X] Basement w/plumbing [ ] Basement wo/plumbing

Water Supply: [X] Individual [ ] Public [ ] Community


Comments/Conditions: Tight - No room for change. Must maintain 100' seperation between Tanks and Well. No basement under Garage area

Comments/Conditions: 600 Points 3/16" holes

INITIAL SITE SKETCH

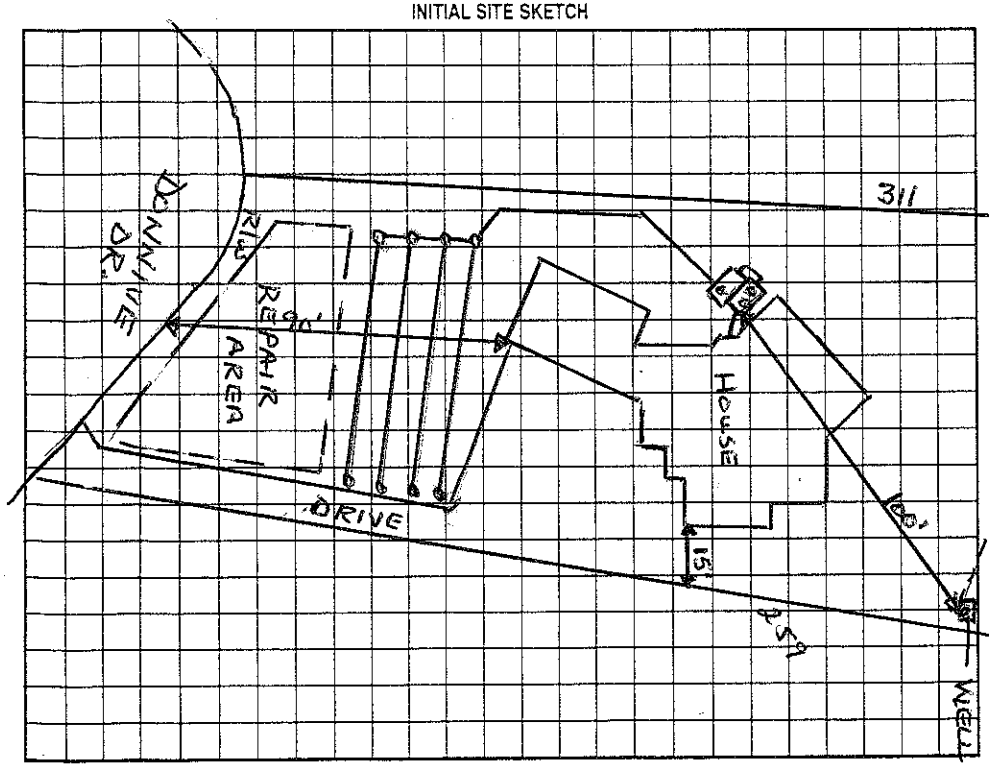

AS BUILT SKETCH

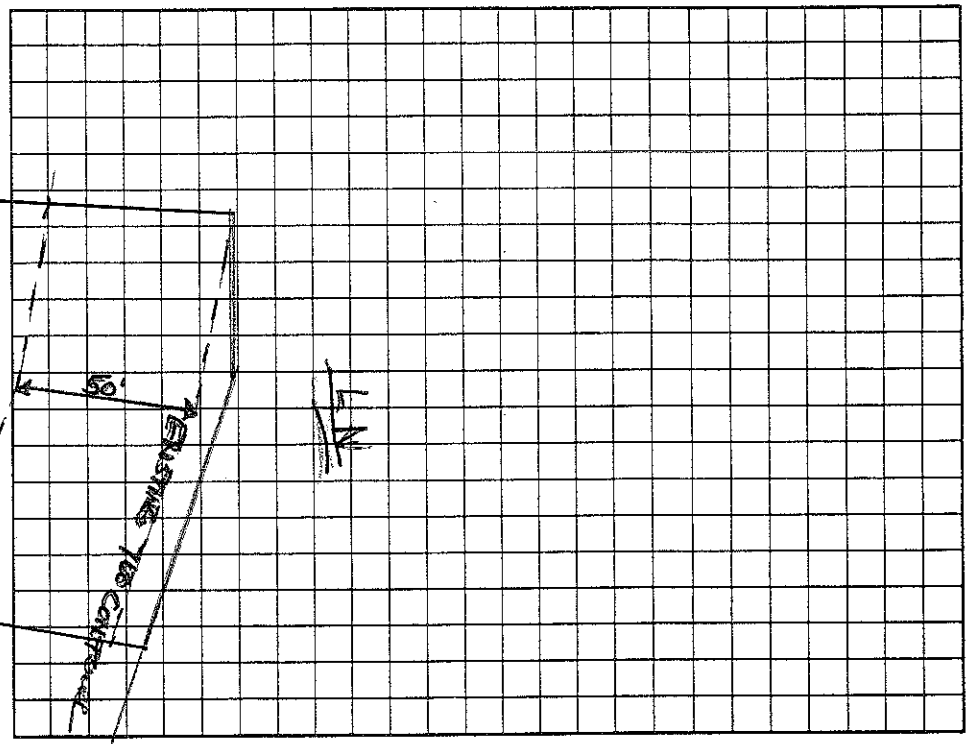

Permit can be suspended or revoked if any false information is supplied toward securing the permit/any unauthorized changes are made to the site/any unauthorized changes are made in the installation of the system. Improvement Permit with plat valid without expiration. Improvement Permit with site plan valid for sixty months. Authorization to Construct is valid for a period equal to that of Improvement Permit – not to exceed sixty months.

Signed: [signature] date 1/29/04

Improvement Permit by: Wesley Sparks RS. date 1/28/04

Authorization to Construct by: Wesley Sparks RS date 1/28/04

Installed by: Steve Jordan

Operation Permit by: [signature] RS date 10/18/04

Existing System Inspection by: date

HEALTH DEPT. COPY: WHITE OWNER COPY (FINAL): YELLOW OWNER COPY (INITIAL): PINK