IMPROVEMENT PERMIT / AUTHORIZATION TO CONSTRUCT / OPERATION PERMIT / EXISTING SYSTEM INSPECTION

PERMIT# 21773 PIN# 4646 78 2524 DATE 1/28/04

OWNER OR CONTRACTOR Kenneth Beaton Homes PHONE: Business 704-662-6480 Home

ADDRESS PO Box 3398 Monroe NC 28111

LOCATION 1100 TL Dibble Rd. TR Off Rt. Morrison to R TR Dominion Lee Last Lot on (R)

SUBDIVISION Dibble Cove BLOCK / SECTION LOT 26 LOT AREA ~1 Ac SITE CLASS PS DESIGN FLOW 480 L.T.A.R. .3

Septic Tank: 1000 Gallons; SIB Date

Pump Tank: 1000 Gallons, PT Date

Pump Make: Model Serial No.

Nitrification Field: No Fields 1 Square Feet 536 Linear Feet 268

No Lines 4@67' Trench Width 2' Max Trench Bottom Depth 3 Gravel Depth NA

[X] New System [ ] Repair System Type: I, II, III, IV, V

System Description: Pump Tank - 16" PPB RS

Repair System Description: Same Type

Maintenance Agreement Required: [X] Yes [ ] No

[X] House/Mod. Home No. Bedrooms 4

[ ] Mobile Home No. Bathrooms 5

[ ] Business No. Employees

[ ] Other


[ ] Slab [ ] Crawl Space [X] Basement w/plumbing [ ] Basement w/o plumbing

Water Supply: [X] Individual [ ] Public [ ] Community


Comments/Conditions: Tight - No room for change. Must maintain 36" separation between Tanks and Walls No basement under Garage area

Comments/Conditions:

INITIAL SITE SKETCH

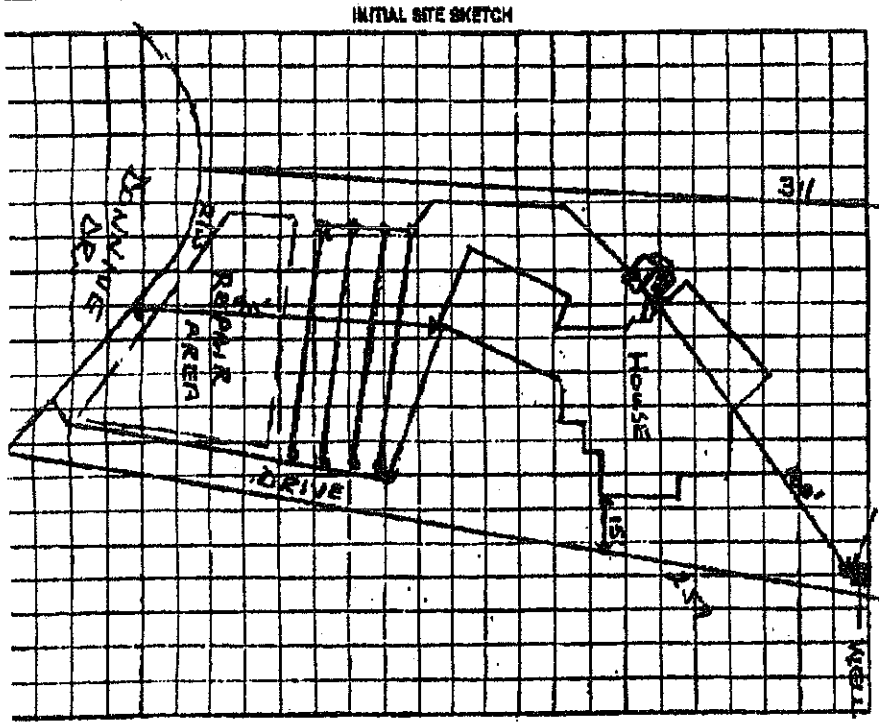

AS BUILT SKETCH

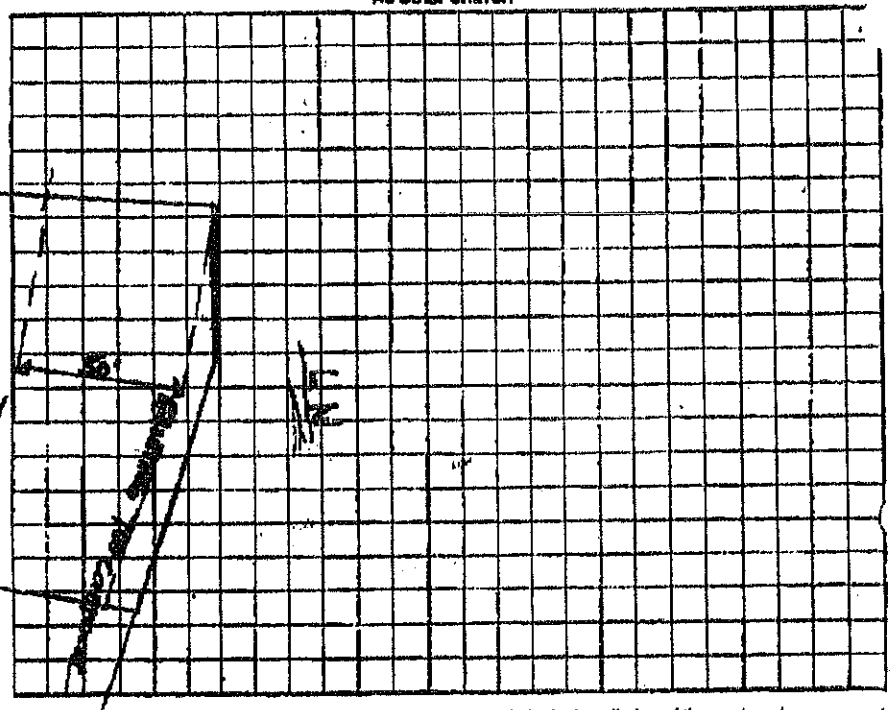

Permit can be suspended or revoked if any false information is supplied toward securing the permit/any unauthorized changes are made to the site/any unauthorized changes are made in the installation of the system. Improvement Permit with plat valid without expiration. Improvement Permit with site plan valid for sixty months. Authorization to Construct is valid for a period equal to that of Improvement Permit – not to exceed sixty months.

Signed: [signature] date 1/29/04

Improvement Permit by: Wendy Sparks RS. date 1/28/04

Authorization to Construct by: Wendy Sparks RS date 1/28/04

Installed by: date

Operation Permit by: date

Existing System Inspection by: date

HEALTH DEPT COPY: WHITE OWNER COPY (FINAL): YELLOW OWNER COPY (INITIAL): PINK

Terry / Nesbitt 150 * 21 * 50147

Attn: Kevin