IREDELL COUNTY HEALTH DEPARTMENT

STATESVILLE 704-878-5305 MOORESVILLE 704-664-5281

IMPROVEMENT PERMIT / AUTHORIZATION TO CONSTRUCT / OPERATION PERMIT / EXISTING SYSTEM INSPECTION

PERMIT# 21776/118280 PIN# 4646 78 2324 DATE 3/11/03

OWNER OR CONTRACTOR Margaret Rabon PHONE: Business _____ Home 704-855-1935

ADDRESS 210 Bastian St, China Grove, NC. 28023

LOCATION 1100 Tl Hills Rd. TR Apple Blossom on (12) at the sharp curve

SUBDIVISION GIBBS COVE BLOCK / SECTION PH 2 LOT 29 LOT AREA ~.9Ac SITE CLASS. PS DESIGN FLOW 360 L.T.A.R. .3

Septic Tank: 1000 Gallons; STB 1012 Date 12/7/04
Pump Tank: 1000 Gallons; PT 17 Date 1/25/05
Pump Make: Gould's Model WE0571 Serial No. _____
Nitrification Field: No Fields 1 Square Feet 400 Linear Feet 200
No Lines 4@50' Trench Width 2' Max Trench Bottom Depth 3' Gravel Depth No

☒ New System ☐ Repair System Type: I, II, III, IV, V, VI
System Description: 1000 GPBPS
Repair System Description: Same
Maintenance Agreement Required: ☒ Yes ☐ No

☒ House/Mod. Home No. Bedrooms #3 4
☐ Mobile Home No. Bathrooms 4
☐ Business No. Employees _____
☐ Other _____

☐ Slab ☒ Crawl Space ☐ Basement w/plumbing ☐ Basement wo/plumbing


Water Supply: ☒ Individual ☐ Public ☐ Community

Comments:/Conditions: Must have 100' separation between all parts of Septic Tank System and drilled well.


Comments:/Conditions: House is 3 bedroom & sets closer to the Lake

INITIAL SITE SKETCH

(1" = 40')

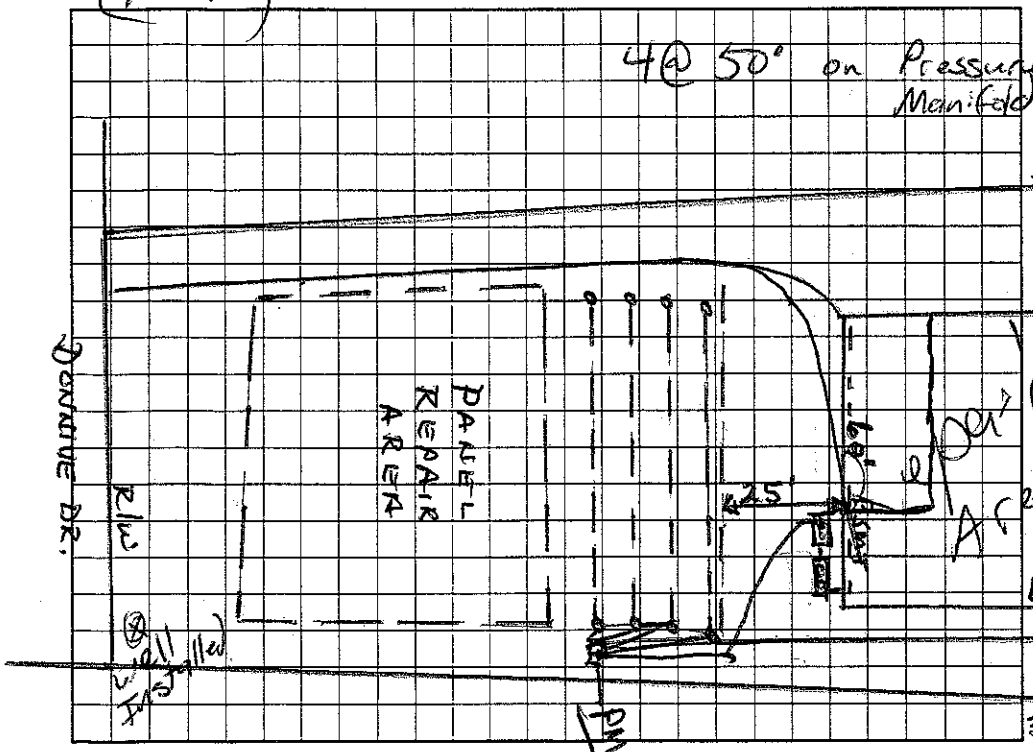

AS BUILT SKETCH

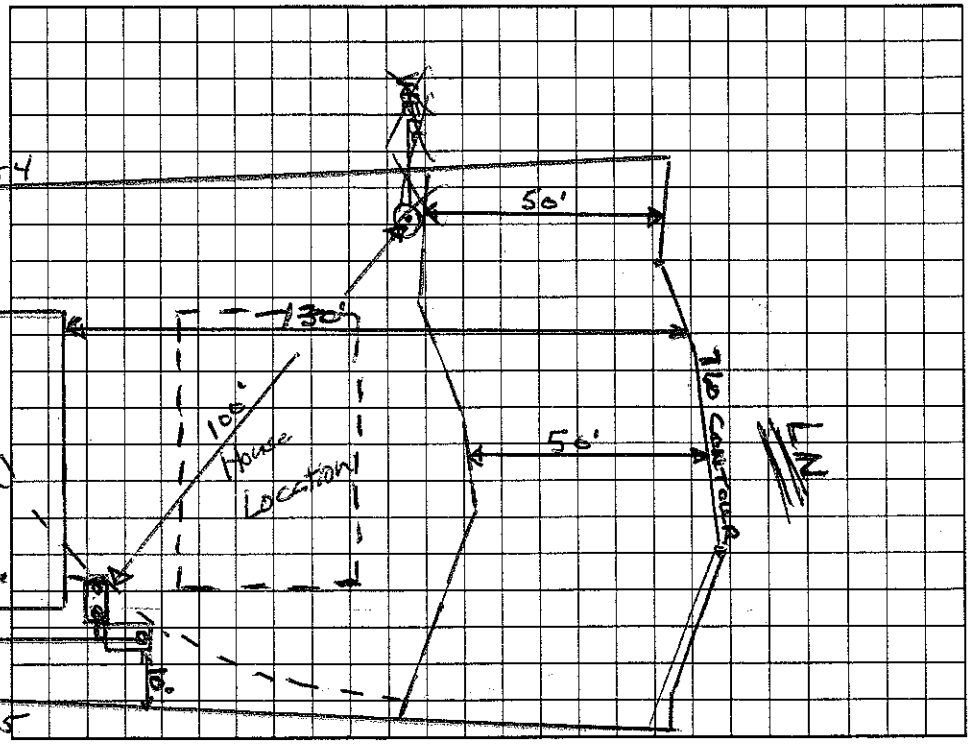

Permit can be suspended or revoked if any false information is supplied toward securing the permit/any unauthorized changes are made to the site/any unauthorized changes are made in the installation of the system. Improvement Permit with plat valid without expiration. Improvement Permit with site plan valid for sixty months. Authorization to Construct is valid for a period equal to that of Improvement Permit – not to exceed sixty months.

Signed: Margaret C. Rabon date 3-11-03

Improvement Permit by: Wesley Sparks RS. date 3/11/03

Authorization to Construct by: Wesley Sparks RS. date 1/9/04

Installed by: A-1 Backhoe

Operation Permit by: Wesley Sparks RS. date 2/26/04

Existing System Inspection by: _____ date _____

HEALTH DEPT. COPY: WHITE OWNER COPY (FINAL): YELLOW OWNER COPY (INITIAL): PINK