4646-77-0384

IREDELL COUNTY HEALTH DEPARTMENT

STATESVILLE 704-878-5305 MOORESVILLE 704-664-5281

IMPROVEMENT PERMIT / CERTIFICATE OF COMPLETION / OPERATION PERMIT / EXISTING SYSTEM INSPECTION

PROPERTY DESCRIPTION NO. 3432 DATE 8/26/95 TAX MAP NO. 2J 18A 53 Watershed: [X] Yes [ ] No

OWNER OR CONTRACTOR TINA MILLER PHONE: Business 483-1279 Home

ADDRESS PO BOX 733 DENVER, NC 28037

LOCATION Brawley Sch TL on Dilbo Rd. straight lot on (R) before intersection lot

SUBDIVISION DilboCove BLOCK / SECTION 1 LOT 53 LOT AREA .69 AC SITE CLASS PS DESIGN FLOW 360 L.T.A.R. .3

Septic Tank: 1000 Gallons; STB 795 Date

Pump Tank: Gallons; PT Date

Pump Make: Model Serial No.

Nitrification Field: No Fields 1 Square Feet 1200 Linear Feet 400

No Lines 5 Trench Width 36" Max Trench Bottom Depth 36" Gravel Depth 12"

[X] New System [ ] Repair System Type: I, [X] III, IV, V, VI

System Description: CONV - DIST BOX

Repair System Description: GRAV - INFILTRATOR

Maintenance Agreement Required: [ ] Yes [X] No

[X] House/Mod. Home No. Bedrooms 3

[ ] Mobile Home No. Bathrooms 2

[ ] Business No. Employees

[ ] Other


[ ] Slab [X] Crawl Space [ ] Basement w/plumbing [ ] Basement wo/plumbing

Water Supply: [X] Individual [ ] Community [ ] Public

Comments: 5 @ 80' x 3' CONVENTIONAL

Comments:

INITIAL SITE SKETCH

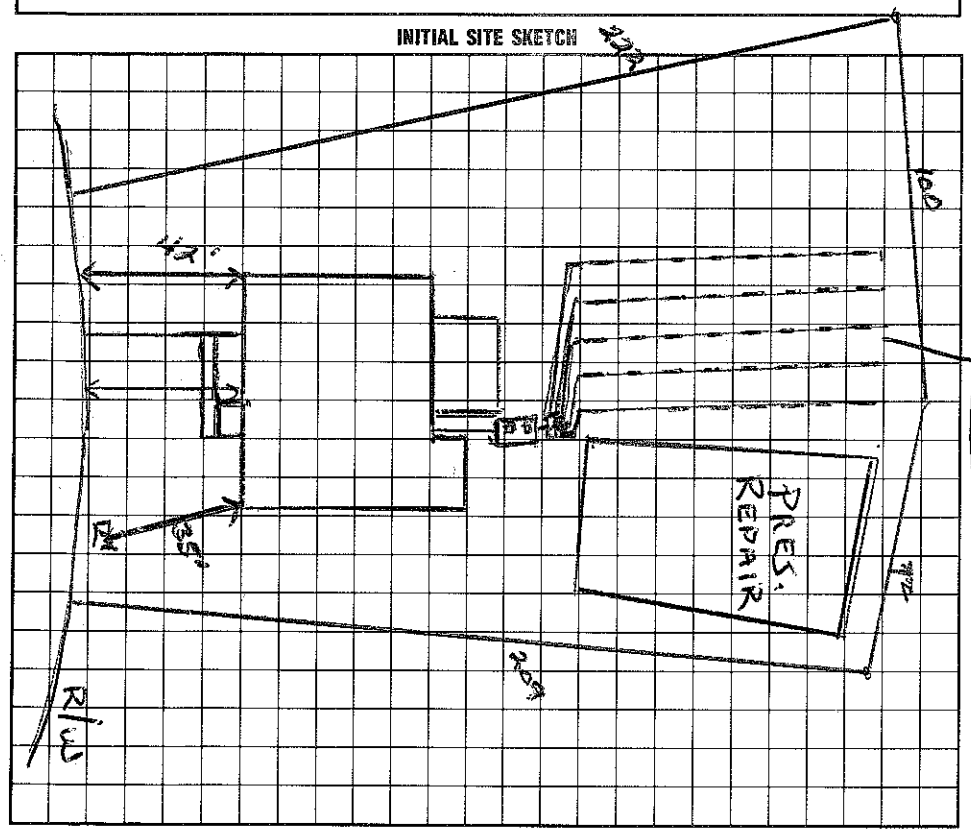

AS BUILT SKETCH

I understand that this permit can be suspended or revoked if any false information is supplied toward securing the permit/any unauthorized changes are made to the site/any unauthorized changes are made in the installation of the system.

Signed: Tina B Miller

Improvement Permit by: Wesley Sparks RS. date 8/26/95

Existing System Inspection by: date

Installed by: Dennis Hoyle

Certificate of Completion by: date

Operation Permit by: Wesley Sparks RS. date 8/22/96

HEALTH DEPT. COPY: WHITE INSPECTION COPY (FINAL): GREEN OWNER COPY (FINAL): YELLOW INSPECTION COPY (INITIAL): PINK OWNER COPY (INITIAL): GOLD